

WAYNE MISSISSIPPI BOARD OF WATER COMMISSIONERS

N75

7-22-64

WATER WELL DRILLERS LOG


Date: July 22, 1964, Driller: Porter Drilling & Pump County Wayne  
 (Name)

(1) Owner of Land: <u>Neil Cumberland</u> (Name)	Description & Color of Materials Sand, Clay, Red Clay, Shell, etc.	Thick- ness Feet	Depth Feet
<u>At 3 Waynesboro, Miss</u> (Address)	<u>red clay</u>	10	10
	<u>sand</u>	5	15
(2) Location <u>NW 1/4, NE 1/4, Sec. 35 T8 R 7,</u> <u>4</u> miles <u>south</u> of <u>Waynesboro</u> (distance) (direction) (Nearest Town)	<u>chert</u>	20	45
	<u>thin rock</u>		45
(3) Topography: <u>hilly</u> (Hilly) (Flat) (Level)	<u>sand</u>	5	50
(4) Purpose of Well: <u>domestic</u> (Domestic Irrigation Municipal, Industrial, Other)	<u>chert</u>	7	57
	<u>sand</u>	1	58
	<u>chert</u>	2	60
	<u>red sand</u>	6	66

Information upon completion of well:

- (1) Diameter 2" inches.
- (2) Total Depth 66' feet.
- (3) Water Level 38' feet below top of ground.
- (4) Cased to 58', Size 2"
- (5) Screen: Size 1 1/4", Length 6'  
plastic mesh
- (6) Were any formations sealed against pollution?  
no

If YES depth of formation \_\_\_\_\_  
 Why \_\_\_\_\_  
 Drillers Remarks: \_\_\_\_\_

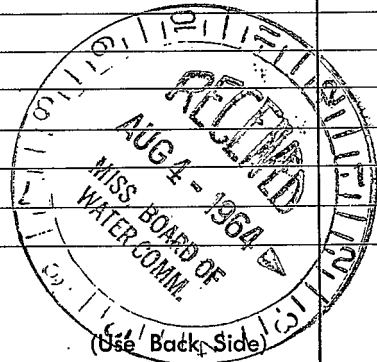

Well No.

[The page contains extremely faint and illegible text, likely bleed-through from the reverse side of the document. The text is scattered across the page and cannot be transcribed accurately.]