

WAYNE
N78
6-63

WATER WELL DRILLERS LOG

CODED

Date: June, 1963, Driller: Peepers Drilling Co County Wayne

399/32

(Name)

(1) Owner of Land: Wesley T. Burnett
(Name)

(Address)

(2) Location: 1/4, 1/4, Sec. 9 T. 8. R. 7,
4 miles West of Waynesboro
(distance) (direction) (Nearest Town)

(3) Topography: Hilly
(Hilly) (Flat) (Level)

(4) Purpose of Well: Domestic
(Domestic Irrigation
Municipal, Industrial, Other)

Information upon completion of well:

- (1) Diameter 2 inches.
- (2) Total Depth 132 feet.
- (3) Water Level 90 feet below top of ground.
- (4) Cased to 126', Size 2"
- (5) Screen: Size 2", Length 6'
- (6) Were any formations sealed against pollution?
yes, no.


If YES depth of formation _____

Why _____

Drillers Remarks: _____

Description & Color of Materials Sand, Clay, Red Clay, Shell, etc.	Thick-ness Feet	Depth Feet
Red sandy clay	10	10
Red sand	15	25
White clay + small white sand streaks	26	51
Red sand in coarse Red sand	81	132

CODED

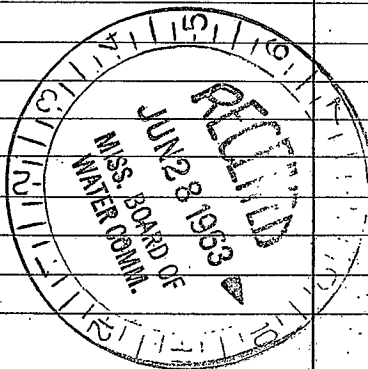

(Use Back Side)

Well No.

