

Wayne
 N 82
 2-68

MISSISSIPPI
 BOARD OF WATER COMMISSIONERS
 416 North State Street
 Jackson, Mississippi 39201

WATER WELL DRILLERS LOG

Feb. 13 1968 Carter Drilling & Log Wayne
 date well completed firm name county well located

LANDOWNER: James A. Venter

description of formations encountered

from to

211 Waynesboro, Miss.
 (mailing address)

red clay	0	10
fine sand	10	52
coarse dry sand	52	60
chalk & sand	60	72
med coarse sand	72	84
stagnant white stuff		

WELL LOCATION:

sec. 6 T. 8 N. R. 7 E.
 S. W. E.
 5 miles west of Waynesboro in sand
 (distance) (direction) (nearest town)

WELL PURPOSE: home
 (home, irrigation, municipal, industrial)


WELL COMPLETION DATA:

- (1) diameter (inches) 2"
- (2) total depth (feet) 84'
- (3) static water level (feet) 71' below top of ground.
- (4) casing, steel, 78' (material) (depth)
 2" (size) if telescope see back.
- (5) screen 5' 79' (length) (depth to top)
 1/4" slot Johnson S.S. (size) (material)
- (6) pump 1/2 HP 3 1/2 (HP) (yield gpm)
 elec. (type power)
- (7) electric log no (yes or no)

(organization running log)


(8) how well bottom plugged flush screen

DRILLERS REMARKS:

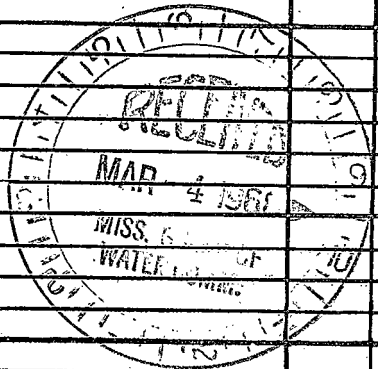

If well telescopes please sketch and show depths.

GROUND LEVEL

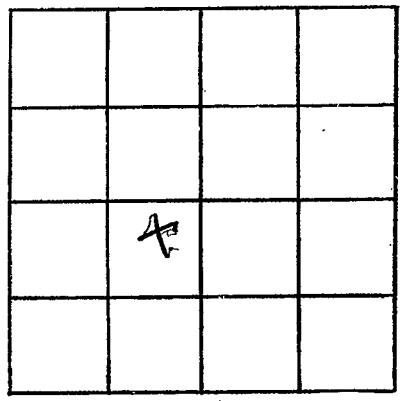

SECTION 6

Please indicate well location X.

ADDITIONAL INFORMATION

Lined area for additional information.

If more than one screen, show locations of each on sketch.