

59 37' 02" 80° 41' 17"

WAYNE  
N 84  
4-68

MISSISSIPPI  
BOARD OF WATER COMMISSIONERS  
416 North State Street  
Jackson, Mississippi 39201

69

WATER WELL DRILLERS LOG

April 22, 1968 Porter Drilling & Log Wayne  
date well completed firm name county well located

LANDOWNER: J. L. Martin  
Jr. Jarma Homes 667  
Waynesboro Miss  
(mailing address)

description of formations encountered	from	to
red clay	0	8
Chalk	8	16
sand	16	26
sand & chalk	26	30
thin rock		30
Chalk	30	145
Chalk & little sand	145	168
med fine clean sand	168	189
med to coarse sand	189	196
stagnant water level in sand		


WELL LOCATION:  
sec. 34 T 8 N R 7 E  
4 miles S of Waynesboro  
(distance) (direction) (nearest town)

WELL PURPOSE: for homes  
(home, irrigation, municipal, industrial)

WELL COMPLETION DATA:


- (1) diameter (inches) 2"
- (2) total depth (feet) 196'
- (3) static water level (feet) 78' <sup>(below)</sup> <sub>(above)</sub> top of ground.
- (4) casing steel 189'  
(material) (depth)  
2" if telescope see back.  
(size)
- (5) screen 5' 191'  
1" (length) (depth to top)  
14 slot Johnson S.S.  
(size) (material)
- (6) pump 1/2 rod 3 1/2  
(HP) (yield gpm)  
elec.  
(type power)
- (7) electric log no  
(yes or no)  
  
(organization running log)
- (8) how well bottom plugged  
flush point

DRILLERS REMARKS:

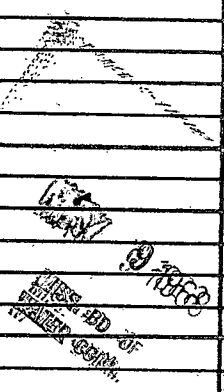

If well telescopes please sketch and show depths.

GROUND LEVEL

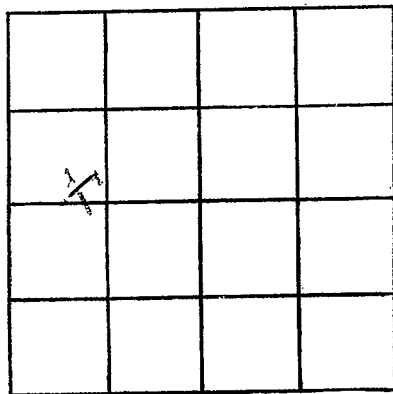

SECTION 34

Please indicate well location X.

ADDITIONAL INFORMATION

If more than one screen, show locations of each on sketch.