

393904 088721

WAYNE
N85
4-68

MISSISSIPPI
BOARD OF WATER COMMISSIONERS
416 North State Street
Jackson, Mississippi 39201

13

WATER WELL DRILLERS LOG

April 5, 1968 Porter Drilling Co Wayne
date well completed firm name county well located

LANDOWNER: Floyd Mc Cormick Jr.
At 1 Waynesboro Miss
(mailing address)

description of formations encountered	from	to
red clay	0	10
striped chalk	10	65
chalk & sand	65	140
soft loose sand	140	188
blue chalk	188	230
rock strata	230	266
blue chalk	266	270
med course sand		
with some chalk streaks	270	309
blue chalk	309	361
Richburg heavy sand		
rock	361	392


WELL LOCATION:
sec 19 T 8N R 7E
S W
6 miles west of Waynesboro
(distance) (direction) (nearest town)

WELL PURPOSE: home
(home, irrigation, municipal, industrial)

WELL COMPLETION DATA:

- (1) diameter (inches) 2"
- (2) total depth (feet) 392'
- (3) static water level (feet) 125' ^{below} top of ground.
- (4) casing steel, 362 1/2'
(material) (depth)
2' if telescope see back.
(size)
- (5) screen none used
(length) (depth to top)
(size) (material)
- (6) pump 2 6
(HP) (yield gpm)
elec
(type power)
- (7) electric log no
(yes or no)
(organization running log)
- (8) how well bottom plugged open end

147' 1 1/4" log pipe

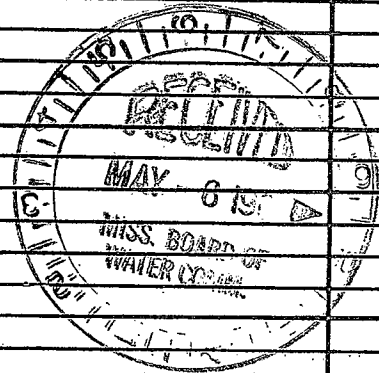

DRILLERS REMARKS:
Casing sealed off in
rock with 3 1/2" blasting

If well telescopes please sketch and show depths.

GROUND LEVEL

X			

SECTION 12

Please indicate well location X.

ADDITIONAL INFORMATION

If more than one screen,
show locations of each on sketch.