

C. P. CLARK
WATER WELL DRILLING
ROUTE 2
LAUREL, Miss. 39440

MISSISSIPPI
BOARD OF WATER COMMISSIONERS
416 North State Street
Jackson, Mississippi 39201


CODED

WATER WELL DRILLERS LOG

Wayne
N 86
7-68

7/11 1968 C.P. Clark Wayne
date well completed firm name county well located

LANDOWNER:	description of formations encountered	from	to
lined homes Rt #1			
Waynesboro Miss (mailing address)	Clay Clay & mud shales fine sand	0 50 108	50 108 155
WELL LOCATION: sec. 1 T. 8N R. 7E 1 miles NE of Waynesboro (distance) (direction) (nearest town)			
WELL PURPOSE: Homes (home, irrigation, municipal, industrial)			
WELL COMPLETION DATA:			
(1) diameter (inches) 2			
(2) total depth (feet) 155			
(3) static water level (feet) 65 below top of ground.			
(4) casing Galvalume 131 (material) (depth)			
2 if telescope see back. (size)			
(5) screen 24 155 (length) (depth to top)			
1 1/2 Bronze (size) (material)			
(6) pump 1 1/2 10 (HP) (yield gpm)			
220V Single P. (type power)			
(7) electric log no (yes or no)			
(organization running log)			
(8) how well bottom plugged BWU			
DRILLERS REMARKS:			

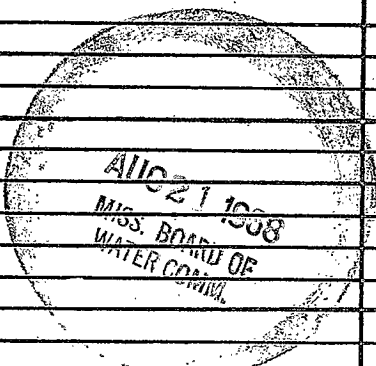

If well telescopes please sketch and show depths.

GROUND LEVEL

			+

SECTION _____

Please indicate well location X.

ADDITIONAL INFORMATION

If more than one screen,
show locations of each on sketch.