

Wayne
 N 87
 9-68

MISSISSIPPI
 BOARD OF WATER COMMISSIONERS
 416 North State Street
 Jackson, Mississippi 39201

CODED

WATER WELL DRILLERS LOG

Sept 6 1968 Robert C. Longley Wayne
 date well completed firm name county well located

LANDOWNER: C. H. McAllen
321 American Way
 (mailing address)

description of formations encountered	from	to
<u>sub. clay</u>	<u>0</u>	<u>3</u>
<u>clay</u>	<u>3</u>	<u>14</u>
<u>clay</u>	<u>14</u>	<u>18</u>
<u>blue chert</u>	<u>18</u>	<u>53</u>
<u>blue chert</u>	<u>53</u>	<u>104</u>
<u>blue chert</u>	<u>104</u>	<u>132</u>

WELL LOCATION:
 sec. 11 T. 20 N. R. 7 E.
1 miles W of Waynesboro
 (distance) (direction) (nearest town)


WELL PURPOSE: land
 (home, irrigation, municipal, industrial)

WELL COMPLETION DATA:

- (1) diameter (inches) 2'
- (2) total depth (feet) 132
- (3) static water level (feet) 18 below/above top of ground.
- (4) casing steel 105'
 (material) (depth)
2 if telescope see back.
 (size)
- (5) screen none
 (length) (depth to top)
 (size) (material)
- (6) pump hand 5
 (HP) (yield gpm)
elec
 (type power)
- (7) electric log none
 (yes or no)
 (organization running log)
- (8) how well bottom plugged open

DRILLERS REMARKS:

CODED

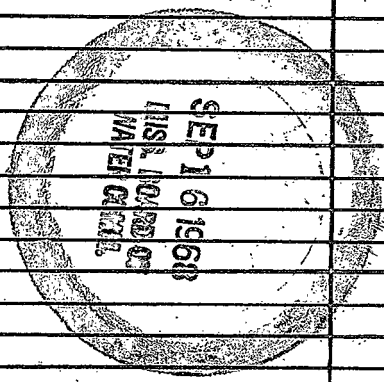

If well telescopes please sketch and show depths.

GROUND LEVEL

X			

SECTION 11

Please indicate well location X.

ADDITIONAL INFORMATION

If more than one screen,
show locations of each on sketch.