

Wayne  
N89  
8-68

MISSISSIPPI  
BOARD OF WATER COMMISSIONERS  
416 North State Street  
Jackson, Mississippi 39201

CODED

WATER WELL DRILLERS LOG

Aug 26 1968 W. B. Water Drilling & Exp. Wayne  
date well completed firm name county well located

LANDOWNER: James H. Cherry

description of formations encountered	from	to
	0	12
	12	43
	43	94
	94	133

Box 32 Waynesboro, Miss  
(mailing address)


WELL LOCATION:  
sec. 11 T. 2 N. R. 7 E.  
1/4 miles W of Waynesboro  
(distance) (direction) (nearest town)

WELL PURPOSE: Drain  
(home, irrigation, municipal, industrial)

WELL COMPLETION DATA:

- (1) diameter (inches) 2"
- (2) total depth (feet) 133'
- (3) static water level (feet) 19' below top of ground.
- (4) casing steel, 95' (material), (depth)  
2" (size) if telescope see back.
- (5) screen none, (length) (depth to top)  
(size) (material)
- (6) pump 1/2 (HP) 12 (yield gpm)  
elec. (type power)
- (7) electric log no (yes or no)  
(organization running log)
- (8) how well bottom plugged \_\_\_\_\_

DRILLERS REMARKS:

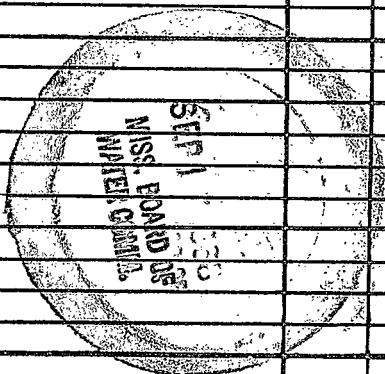

CODED

