

CODED

MISSISSIPPI
BOARD OF WATER COMMISSIONERS
416 North State Street
Jackson, Mississippi 39201

WATER WELL DRILLERS LOG

Wayne
N 90
8-68

Aug 24 1968 Robert Dalling & Son Wayne
date well completed firm name county well located

LANDOWNER: Wayne

description of formations encountered from to

Box 3 Wayneboro Miss.
(mailing address)

sand 0 16
cl. sh. 16 20
sand stratum 20 55
blue shale 55 108
black clay honeycombed 108 132


WELL LOCATION:
sec. 11 T 2 N R 7 E
1/4 miles W of Wayneboro
(distance) (direction) (nearest town)

WELL PURPOSE: drinking
(home, irrigation, municipal, industrial)

WELL COMPLETION DATA:

- (1) diameter (inches) 2"
- (2) total depth (feet) 132'
- (3) static water level (feet) 20' below/above top of ground.
- (4) casing steel, 107'
(material) (depth)
2" if telescope see back.
(size)
- (5) screen none,
(length) (depth to top)
(size) (material)
- (6) pump 3/4 12
(HP) (yield gpm)
elec.
(type power)
- (7) electric log none
(yes or no)
(organization running log)
- (8) how well bottom plugged open


CODED

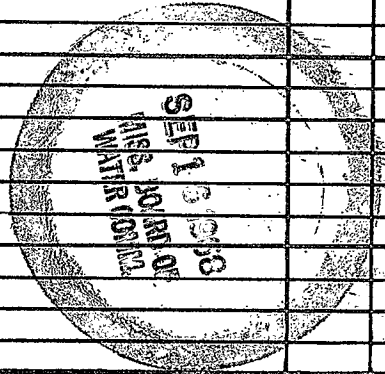

DRILLERS REMARKS:

If well telescopes please sketch and show depths.

GROUND LEVEL

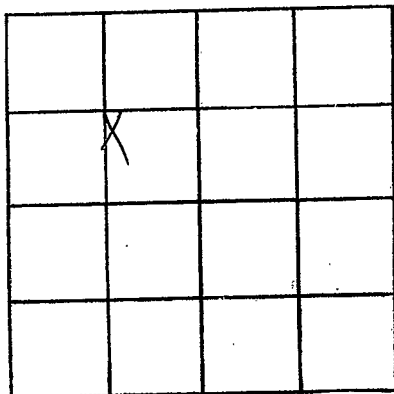

SECTION 11

Please indicate well location X.

ADDITIONAL INFORMATION

If more than one screen, show locations of each on sketch.