

**MISSISSIPPI
BOARD OF WATER COMMISSIONERS**
416 North State Street
Jackson, Mississippi 39201

CODED

Wayne
N 91
8-68

WATER WELL DRILLERS LOG

Aug 28 1968 Porter Drilling & Log Wayne
date well completed firm name county well located

LANDOWNER: James Whites
J

description of formations encountered	from	to
---------------------------------------	------	----

211 Waverstone Miss
(mailing address)

sand & chalk	0	32
blue chalk	32	52
fine blue sand	52	87
& chalk sand		
blue chalk	87	119
sand	119	121
blue chalk	121	125
rock strata	125	159
blue chalk	159	202
Dickinson limestone	202	223

WELL LOCATION:
sec. 32 T 90 N R 7 E
W miles W of Waynesboro
(distance) (direction) (nearest town)


WELL PURPOSE: house
(home, irrigation, municipal, industrial)

WELL COMPLETION DATA:

- (1) diameter (inches) 2"
- (2) total depth (feet) 237
- (3) static water level (feet) 115 below above top of ground.
- (4) casing steel, 2 1/2" (material) (depth)
2" (size) If telescope see back.
- (5) screen none, (length) (depth to top)
(size) (material)
- (6) pump hand 3 1/2 (HP) (yield gpm)
elec. (type power)
- (7) electric log _____ (yes or no)
(organization running log)
- (8) how well bottom plugged open


DRILLERS REMARKS:

CODED

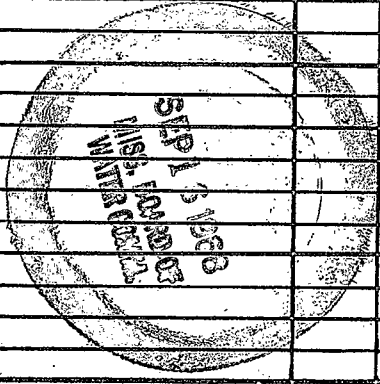

If well telescopes please sketch and show depths.

GROUND LEVEL

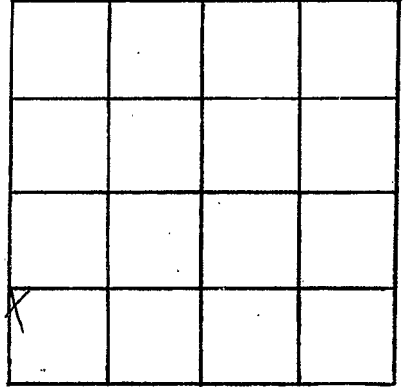

SECTION 32

Please indicate well location X.

ADDITIONAL INFORMATION

If more than one screen,
show locations of each on sketch.