

WAYNE  
 N 92  
 7-28-69

MISSISSIPPI  
 BOARD OF WATER COMMISSIONERS  
 416 North State Street  
 Jackson, Mississippi 39201

CODED

WATER WELL DRILLERS LOG

July 28 1969 Origin Well Service Wayne  
 date well completed firm name county well located

LANDOWNER: Carl Brewer  
Henef.  
Waynesboro, Miss  
 (mailing address)

description of formations encountered	from	to
	Sand	0
Blue shale	15	25
Clay	25	50
Sand	50	60

WELL LOCATION:  
 sec. B T 8 (N) R 7 (E)  
1 miles S of Waynesboro  
 (distance) (direction) (nearest town)

WELL PURPOSE: Home  
 (home, irrigation, municipal, industrial)

- WELL COMPLETION DATA:
- (1) diameter (inches) 2
  - (2) total depth (feet) 60
  - (3) static water level (feet) 10 below above top of ground
  - (4) casing Gal 60  
 (material) (depth)
  - if telescope see back.  
 (size)
  - (5) screen 6 60  
 (length) (depth to top)  
2" Steel  
 (size) (material)
  - (6) pump 1 14  
 (HP) (yield/gpm)  
Elc  
 (type power)
  - (7) electric log NO  
 (yes or no)  
NO  
 (organization running log)
  - (8) how well bottom plugged B.W

CODED


WAR 21 1969

MISS. RD. DE  
 WATER COMM.

DRILLERS REMARKS:

If well telescopes please sketch and show depths.

GROUND LEVEL

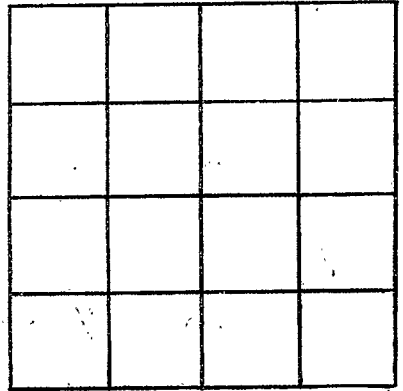

SECTION \_\_\_\_\_

Please indicate well location X.

ADDITIONAL INFORMATION

If more than one screen,  
show locations of each on sketch.