

**MISSISSIPPI
BOARD OF WATER COMMISSIONERS**
416 North State Street
Jackson, Mississippi 39201

CODED

WATER WELL DRILLERS LOG

Wayne
N97
6-4-69

June 4 1969 Porter Drilling & Log Wayne
date well completed firm name county well located


LANDOWNER:	description of formations encountered	from	to
<u>Mr. Beatha</u>	<u>red sandy clay</u>	<u>0</u>	<u>8</u>
<u>Carson Rt. 3</u>	<u>sand & chalk</u>	<u>8</u>	<u>60</u>
<u>Waynesboro Miss</u>	<u>clean med coarse sand</u>	<u>60</u>	<u>86</u>
<u>(mailing address)</u>	<u>med sand & chalk</u>	<u>86</u>	<u>95</u>
WELL LOCATION:	<u>med sand</u>	<u>95</u>	<u>100</u>
sec. <u>3</u> T <u>80</u> N R <u>2</u> E	<u>stagnant white silty</u>		
<u>2</u> miles <u>N.W.</u> of <u>Waynesboro</u>	<u>lin sand</u>		
(distance) (direction) (nearest town)			
WELL PURPOSE: <u>home</u>	<u>6' 1/4 80 ga S.S. with</u>		
(home, irrigation, municipal, industrial)	<u>2' 1/4 log with 2 with</u>		
WELL COMPLETION DATA:	<u>Racker</u>		
(1) diameter (inches) <u>2"</u>	<u>84' 1/4 log pipe</u>		
(2) total depth (feet) <u>100'</u>			
(3) static water level (feet) <u>75</u> <u>below</u> <u>above</u>			
(4) casing <u>steel</u> <u>94'</u>			
(material) (depth)			
<u>2"</u> if telescope see back.			
(size)			
(5) screen <u>6"</u> <u>94'</u>			
(length) (depth to top)			
<u>1/4</u> <u>80 ga S.S.</u>			
(size) (material)			
(6) pump <u>1</u> <u>5</u>			
(HP) (yield gpm)			
<u>elec</u>			
(type power)			
(7) electric log <u>no</u>			
(yes or no)			
(organization running log)			
(8) how well bottom plugged <u>flush point</u>			
DRILLERS REMARKS:			

JUN 9 - 1969

MISS. BD. OF
WATER COMM

If well telescopes please sketch and show depths.

GROUND LEVEL

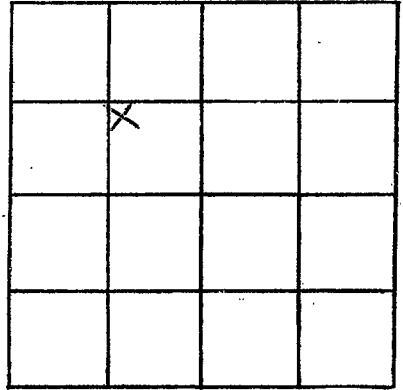

SECTION 3

Please indicate well location X.

ADDITIONAL INFORMATION

A series of 18 horizontal lines for writing additional information.

If more than one screen, show locations of each on sketch.