

Wayne
 N 98,
 6-19-69

MISSISSIPPI
 BOARD OF WATER COMMISSIONERS
 416 North State Street
 Jackson, Mississippi 39201

CODED

WATER WELL DRILLERS LOG


June 19, 1969 Boots Drilling & Log Wayne
 date well completed firm name county well located


| LANDOWNER: <u>J. A. Chapman</u> | description of formations encountered | from | to |
|---|---------------------------------------|------------|------------|
| <u>Box 44</u> | <u>red clay</u> | <u>0</u> | <u>9</u> |
| <u>Warnerboro Miss</u> | <u>sand & chalk</u> | <u>9</u> | <u>18</u> |
| <u>(mailing address)</u> | <u>red chalk</u> | <u>18</u> | <u>30</u> |
| WELL LOCATION: | <u>blue chalk</u> | <u>30</u> | <u>46</u> |
| sec. <u>1</u> T. <u>90</u> N. R. <u>7</u> E | <u>rock strata</u> | <u>46</u> | <u>82</u> |
| <u>1/4</u> miles <u>N</u> of <u>Warnerboro</u> | <u>blue chalk</u> | <u>82</u> | <u>84</u> |
| (distance) (direction) (nearest town) | <u>war sand & chalk</u> | <u>84</u> | <u>106</u> |
| WELL PURPOSE: <u>home</u> | <u>blue chalk</u> | <u>106</u> | <u>146</u> |
| (home, irrigation, municipal, industrial) | <u>Warnerboro limestone</u> | | |
| WELL COMPLETION DATA: | <u>rock II</u> | <u>146</u> | <u>172</u> |
| (1) diameter (inches) <u>2"</u> | | | |
| (2) total depth (feet) <u>172</u> | <u>3 1/2" bucket on end of</u> | | |
| (3) static water level (feet) <u>92</u> <u>below</u> top of ground. | <u>Case severed into rock</u> | | |
| (4) casing <u>steel</u> <u>146</u> | <u>101' 1 1/4" large pipe</u> | | |
| (material) (depth) | | | |
| <u>2"</u> If telescope see back. | | | |
| (size) | | | |
| (5) screen <u>no metal</u> | | | |
| (length) (depth to top) | | | |
| (size) (material) | | | |
| (6) pump <u>2</u> <u>10</u> | | | |
| (HP) (yield gpm) | | | |
| <u>elec</u> | | | |
| (type power) | | | |
| (7) electric log <u>no</u> | | | |
| (yes or no) | | | |
| (organization running log) | | | |
| (8) how well bottom plugged <u>open</u> | | | |
| DRILLERS REMARKS: | | | |

MISS. BD. OF
 WATER COMMISSIONERS

If well telescopes please sketch and show depths.

GROUND LEVEL

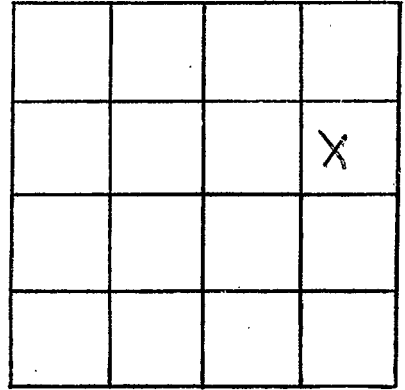

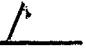SECTION 

Please indicate well location X.

ADDITIONAL INFORMATION

If more than one screen,
show locations of each on sketch.