

WAYNE
 N99
 7-7-69

MISSISSIPPI
 BOARD OF WATER COMMISSIONERS
 416 North State Street
 Jackson, Mississippi 39201

CODED

CODED

WATER WELL DRILLERS LOG

July 7, 1969 Walter R. Williams Wayne
 date well completed firm name county well located

LANDOWNER: Wm. Barnett
243 Wayne, Union Miss
 (mailing address)

WELL LOCATION:
 sec. 9 T. 9 N. R. 7 E.
3 miles west of Hammerbo
 (distance) (direction) (nearest town)

WELL PURPOSE: drinking
 (home, irrigation, municipal, industrial)

- WELL COMPLETION DATA:
- (1) diameter (inches) 4"
 - (2) total depth (feet) 332
 - (3) static water level (feet) 161 below top of ground.
 - (4) casing steel, 301' (material) (depth)
4" (size) if telescope see back.
 - (5) screen wire mesh (length) 18' (depth to top)
4" (size) (material)
 - (6) pump 1 1/2 (HP) 18 (yield gpm)
elec. (type power)
 - (7) electric log none (yes or no)
 (organization running log)
 - (8) how well bottom plugged open


description of formations encountered	from	to
red clay	0	10
Chalk	10	33
shale		33
Chalk	33	60
med. to coarse sand	60	125
blue Chalk	125	196
work stratum	196	236
blue Chalk	236	247
sand	247	251
blue Chalk	251	301
interbedded layers	301	332

DRILLERS REMARKS:

AUG 15 1969
 MISS. ED. 11
 WATER 2201

If well telescopes please
sketch and show depths.

GROUND LEVEL

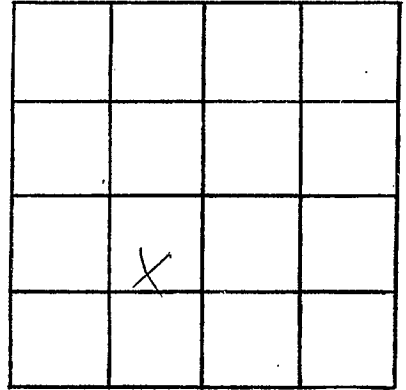

SECTION 9

Please indicate well location X.

ADDITIONAL INFORMATION

If more than one screen,
show locations of each on sketch.