

Wayne
N 100
8-69

MISSISSIPPI
BOARD OF WATER COMMISSIONERS
416 North State Street
Jackson, Mississippi 39201

CODED

CODED

WATER WELL DRILLERS LOG


Aug 4 1969 Booth Drilling & Log Wayne
date well completed firm name county well located

LANDOWNER:	description of formations encountered	from	to
<u>Arthur L. Co</u>	<u>red clay</u>	<u>0</u>	<u>5</u>
<u>13 Hagneston Min</u> (mailing address)	<u>sand & chalk</u>	<u>5</u>	<u>40</u>
WELL LOCATION: sec. <u>19</u> T. <u>20</u> N. R. <u>7</u> E. S. <u>5</u> W. <u>W</u>	<u>hard rock</u>	<u>40</u>	<u>95</u>
<u>5</u> miles <u>west</u> of <u>Hagneston</u> (distance) (direction) (nearest town)	<u>chalk</u>	<u>95</u>	<u>96</u>
WELL PURPOSE: <u>Home</u> (home, irrigation, municipal, industrial)	<u>sandstone sand</u>	<u>96</u>	<u>126</u>
WELL COMPLETION DATA:	<u>shale white sand</u>		
(1) diameter (inches) <u>2"</u>	<u>lime sand</u>		
(2) total depth (feet) <u>139'</u>			
(3) static water level (feet) <u>29'</u> below above top of ground.	<u>12' 1 1/4" 80 gpm screen</u>		
(4) casing <u>steel</u> <u>126'</u> (material) (depth)	<u>well 2 1/2" 1 1/4" deep</u>		
<u>2'</u> if telescope see back. (size)	<u>best in well water</u>		
(5) screen <u>12'</u> <u>126'</u> (length) (depth to top)	<u>105' 1 1/4" deep pipe</u>		
<u>1 1/4"</u> <u>80 gpm S.S.</u> (size) (material)			
(6) pump <u>1</u> <u>4</u> (HP) (yield gpm)			
<u>C.Pac</u> (type power)			
(7) electric log <u>no</u> (yes or no)			
(organization running log)			
(8) how well bottom plugged <u>shale</u>			
DRILLERS REMARKS:			

SEP 4 1969
MISSISSIPPI
BOARD OF WATER COMMISSIONERS

If well telescopes please sketch and show depths.

GROUND LEVEL

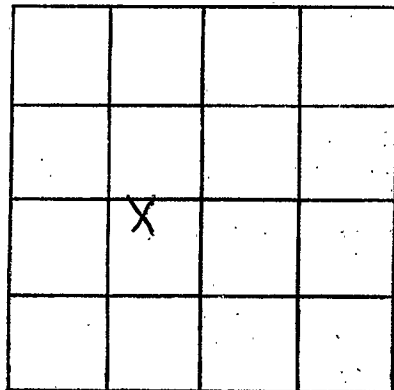

SECTION 19

Please indicate well location X.

ADDITIONAL INFORMATION

If more than one screen,
show locations of each on sketch.