

Wayne  
 N 101  
 9-16-69

MISSISSIPPI  
 BOARD OF WATER COMMISSIONERS  
 416 North State Street  
 Jackson, Mississippi 39201

CODED  
 CODED

WATER WELL DRILLERS LOG

Sept 16 1969 Porter Drilling Co. Wayne  
 (date well completed) (firm name) (county well located)


LANDOWNER: <u>Cecil McMichael</u>	description of formations encountered	from	to
<u>Box 3 Waynesboro Miss</u> (mailing address)	<u>sand</u>	<u>0</u>	<u>17</u>
WELL LOCATION:	<u>blue chalk</u>	<u>17</u>	<u>20</u>
sec <u>10</u> T <u>8</u> N R <u>7</u> E	<u>rock strata</u>	<u>20</u>	<u>63</u>
<u>1 1/2</u> miles <u>west</u> of <u>Waynesboro</u>	<u>blue chalk</u>	<u>63</u>	<u>121</u>
(distance) (direction) (nearest town)	<u>Uchalyng formation</u>	<u>121</u>	<u>151</u>
WELL PURPOSE: <u>for garden</u>	<u>rock</u>		
(home, irrigation, municipal, industrial)	<u>63' 1/4' charge pipe</u>		
WELL COMPLETION DATA:			
(1) diameter (inches) <u>4"</u>			
(2) total depth (feet) <u>151</u>			
(3) static water level (feet) <u>21</u> <u>below</u> <u>above</u>			
top of ground.			
(4) casing <u>steel</u> , <u>121</u>			
(material) (depth)			
<u>4"</u> if telescope see back.			
(size)			
(5) screen <u>none used</u>			
(length) (depth to top)			
(size) (material)			
(6) pump <u>1 1/2</u> <u>30</u>			
(HP) (yield gpm)			
<u>elec</u>			
(type power)			
(7) electric log <u>no</u>			
(yes or no)			
(organization running log)			
(8) how well bottom plugged			
<u>open</u>			
DRILLERS REMARKS:			

SEP 24 1969

MISS. BD. OF  
 WATER COMML.

If well telescopes please sketch and show depths.

GROUND LEVEL

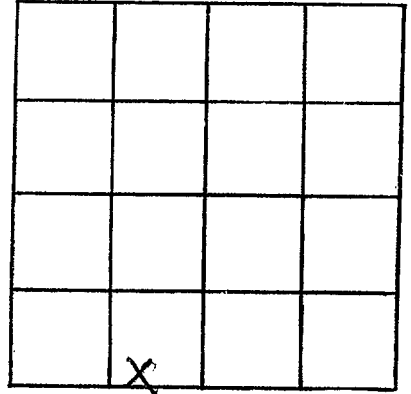

SECTION 10

Please indicate well location X.

ADDITIONAL INFORMATION

If more than one screen,  
show locations of each on sketch.