

Wayne
N102
12-1-69

MISSISSIPPI
BOARD OF WATER COMMISSIONERS
416 North State Street
Jackson, Mississippi 39201

CODED

CODED

WATER WELL DRILLERS LOG

Dec 1 1969 *Porte Drilling & Log* Wayne
date well completed firm name county well located
Walter Karmel *P.O. Box 132* *Waynesboro*


LANDOWNER:	description of formations encountered	from	to
<i>Jean Ann M. Holston</i>			
<i>241 Carrier, Miss</i> (mailing address)	<i>red clay</i>	<i>0</i>	<i>8</i>
	<i>Chalk</i>	<i>9</i>	<i>44.5</i>
	<i>Clean sand and</i>	<i>44.5</i>	<i>49</i>
	<i>sand & chalk</i>	<i>49</i>	<i>55</i>
	<i>Chalk</i>	<i>55</i>	<i>73</i>
	<i>fine sand</i>	<i>73</i>	<i>89</i>
	<i>Coar sand</i>	<i>89</i>	<i>94</i>
	<i>soft sand & some chalk</i>	<i>94</i>	<i>95</i>
	<i>stagnant white steel</i>		
	<i>in sand</i>		
WELL LOCATION: sec. <i>17</i> T. <i>20</i> N. R. <i>7</i> E. S. <i>3 1/2</i> <i>3 1/2</i> miles <i>W</i> of <i>Waynesboro</i> (distance) (direction) (nearest town)			
WELL PURPOSE: <i>Home</i> (home, irrigation, municipal, industrial)			
WELL COMPLETION DATA: (1) diameter (inches) <i>2"</i> (2) total depth (feet) <i>95'</i> (3) static water level (feet) <i>64</i> <i>below</i> top of ground. (4) casing <i>steel</i> <i>89'</i> (material) (depth) <i>2"</i> (size) if telescope see back. (5) screen <i>6'</i> <i>89'</i> (length) (depth to top) <i>1/4"</i> <i>80 ga. S.S.</i> (size) (material) (6) pump <i>over pump out</i> (HR) (yield gpm) (type power) (7) electric log <i>no</i> (yes or no) (organization running log) (8) how well bottom plugged <i>flush pump</i>	<i>6' 1 1/4" 80 ga. S.S. steel</i> <i>in well packer</i>		
DRILLERS REMARKS:			

JAN 12 1970

MISS. BD. OF
WATER COM.

If well telescopes please sketch and show depths.

GROUND LEVEL

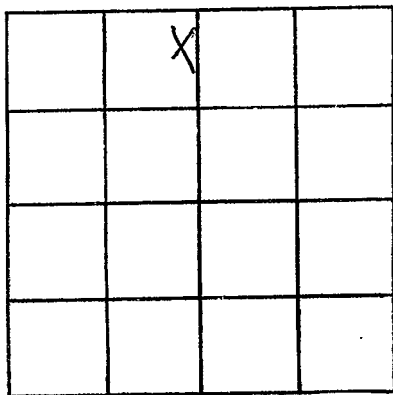

SECTION 17

Please indicate well location X.

ADDITIONAL INFORMATION

If more than one screen, show locations of each on sketch.