

CODED

MISSISSIPPI
BOARD OF WATER COMMISSIONERS
416 North State Street
Jackson, Mississippi 39201

WAYNE
N 109
1-29-70

WATER WELL DRILLERS LOG

Jan 29 1970 Porter Drilling & Log Wayne
date well completed firm name county well located

LANDOWNER: J. S. Portney
Rt 3 Waynesboro Miss
(mailing address)

WELL LOCATION:
sec. 17 T. 20 N. R. 7 E
3 1/2 miles W of Waynesboro
(distance) (direction) (nearest town)

WELL PURPOSE: home
(home, irrigation, municipal, industrial)

- WELL COMPLETION DATA:
- (1) diameter (inches) 2"
 - (2) total depth (feet) 302
 - (3) static water level (feet) 93 below above top of ground.
 - (4) casing steel 2 7/8"
(material) (depth)
2" if telescope see back.
(size)
 - (5) screen none used
(length) (depth to top)
(size) (material)
 - (6) pump 2 (HP) 8 (yield gpm)
elec
(type power)
 - (7) electric log no
(yes or no)
(organization running log)
 - (8) how well bottom plugged open

description of formations encountered	from	to
red clay	0	10
white chalk	10	50
loose sand	50	135
blue chalk	135	151
nick stratum	151	170
blue chalk	170	195
green mud sand	195	227
blue chalk	227	277
black clay, honeycombed	277	302

35' back on 2 1/2"
of casing went into
reduced hole at 278'


FEB 6 - 1970

MISS. BD. OF
WATER COM. 10

DRILLERS REMARKS:

If well telescopes please sketch and show depths.

GROUND LEVEL

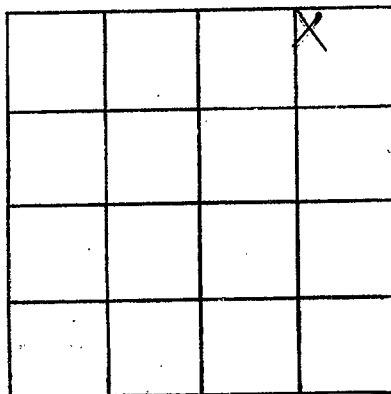

SECTION 12

Please indicate well location X.

ADDITIONAL INFORMATION

If more than one screen,
show locations of each on sketch.