

Wayne Co
 N 106
 10-17-69

MISSISSIPPI
 BOARD OF WATER COMMISSIONERS
 416 North State Street
 Jackson, Mississippi 39201

WATER WELL DRILLERS LOG

Oct 17 1968 Willie Preswall Wayne Co
 date well completed firm name county well located

LANDOWNER:
 Scotch Plywood
 Waynesboro, Miss
 (mailing address)

description of formation encountered	from to	
	feet	feet
Surface Sand	0	25
Mud	25	90
Rock	70	80
Mud	80	105
Sand	105	125

WELL LOCATION:
 sec. 13 T. 8 N R. 7 W
 1 miles S of Waynesboro
 (distance) (direction) (nearest town)

WELL PURPOSE: Domestic
 (home, irrigation, municipal, industrial)

- WELL COMPLETION DATA:
- diameter (inches) 4"
 - total depth (feet) 125
 - static water level (feet) 25 below top of ground.
 - casing Steel (material), (depth) (size) if telescope see back.
 - screen 5 ft, 120 ft (length) (depth to top)
 # 10 slot 4" (size) Stainless (material)
 - pump 1 (HP) 35 (yield gpm)
 Electric (type power)
 - electric log no (yes or no)
- (organization running log)
- (8) how well bottom plugged Wash Craker

COPIED


MAR 30 1970

DRILLERS REMARKS:

MISS. BD. OF
 WATER COMM.

If well telescopes please sketch and show depths.

GROUND LEVEL

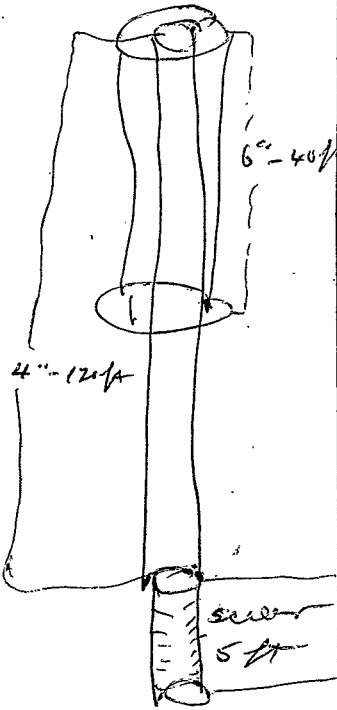

40 ft 6" pipe
120 ft 4" pipe
5 ft screen

6" - 40 ft

4" - 120 ft

seal

5 ft

SECTION _____

Please indicate well location X.

ADDITIONAL INFORMATION

If more than one screen,
show locations of each on sketch.