

Wayne Co
 N 107
 2-21-70

MISSISSIPPI
 BOARD OF WATER COMMISSIONERS
 416 North State Street
 Jackson, Mississippi 39201

WATER WELL DRILLERS LOG

Feb 21 1970 *Willie Presnal Well Drillers* *Wayne*
 date well completed firm name county well located

LANDOWNER:
Scotch Plywood
Waynesboro, Miss
 (mailing address)

WELL LOCATION:
 sec 13 T. 80N R. 10E
 S
 1 miles South of Waynesboro
 (distance) (direction) (nearest town)

WELL PURPOSE: Industrial
 (home, irrigation, municipal, industrial)

- WELL COMPLETION DATA:
- (1) diameter (inches) 4"
 - (2) total depth (feet) 131 ft
 - (3) static water level (feet) 20 below above top of ground.
 - (4) casing Steel (material), (depth) _____
 _____ (size) if telescope see back.
 - (5) screen 10 ft, 12 ft (length) (depth to top)
#10 slot, Stainless (size) (material)
 - (6) pump 1 (HP) 25 (yield gpm)
Electric (type power)
 - (7) electric log no (yes or no)
 _____ (organization running log)
 - (8) how well bottom plugged Back wash valve

description of formations encountered	from	to
<i>Sandstone Sand</i>	<i>0</i>	<i>25</i>
<i>Marl</i>	<i>25</i>	<i>65</i>
<i>Rock</i>	<i>65</i>	<i>76</i>
<i>Marl</i>	<i>76</i>	<i>95</i>
<i>Sand</i>	<i>95</i>	<i>130</i>


DED

MAR 30 1970

MISS. BD. OF WATER COMM.

DRILLERS REMARKS:

If well telescopes please sketch and show depths.

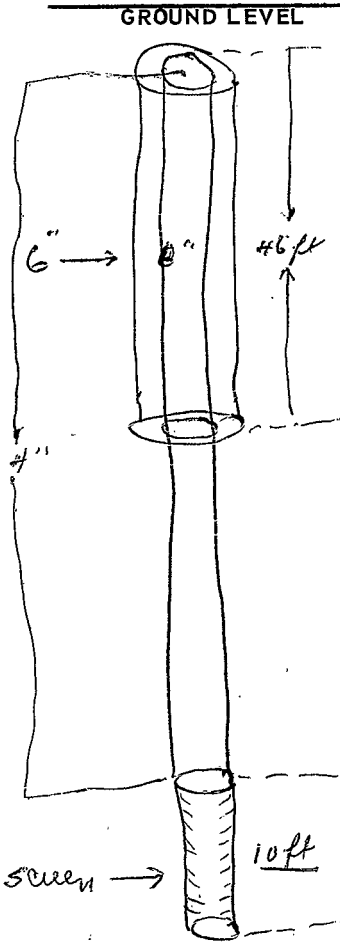

46 ft 6" pipe
 121 ft 4" pipe
 10 ft 4" screen
 #10 slot

SECTION _____

Please indicate well location X.

ADDITIONAL INFORMATION

If more than one screen, show locations of each on sketch.