

Wayne  
 N 108  
 3-6-70

MISSISSIPPI  
 BOARD OF WATER COMMISSIONERS  
 416 North State Street  
 Jackson, Mississippi 39201

WATER WELL DRILLERS LOG

mar 6 1970 Roy West Water Well Wayne  
 date well completed firm name county well located

LANDOWNER: Alford Bunch  
Rt 3 Waynesboro  
 (mailing address)

description of formations encountered	from	to
clay	0	25
pond	25	57
clay	57	125
pond	125	244

WELL LOCATION:  
 sec. 19 T. 8 N. R. 7 E.  
20 miles SW of Waynesboro  
 (distance) (direction) (nearest town)

WELL PURPOSE: dog parlor  
 (home, irrigation, municipal, industrial)

- WELL COMPLETION DATA:
- (1) diameter (inches) 4
  - (2) total depth (feet) 244
  - (3) static water level (feet) 89 below above top of ground.
  - (4) casing galv 234  
 (material) (depth)  
 (size) if telescope see back.
  - (5) screen 10 234  
 (length) (depth to top)  
3 in st steel  
 (size) (material)
  - (6) pump 1 1/2 39  
 (HP) (yield gpm)  
Rca  
 (type power)
  - (7) electric log no  
 (yes or no)

(organization running log)  
 (8) how well bottom plugged Zip plug

DRILLERS REMARKS:

APR - 7 1970


MISS. BD. OF  
 WATER COMM.

FILED

LOGGED

If well telescopes please sketch and show depths.

GROUND LEVEL

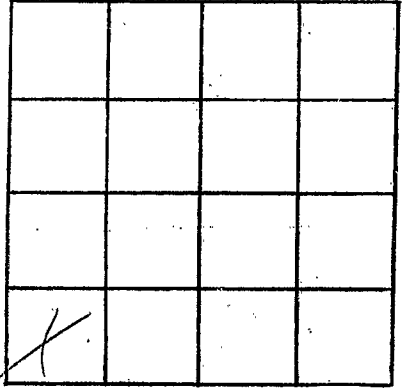

SECTION 19

Please indicate well location X.

ADDITIONAL INFORMATION

If more than one screen,  
show locations of each on sketch.