

Wayne  
N 109  
5-4-70

MISSISSIPPI  
BOARD OF WATER COMMISSIONERS  
416 North State Street  
Jackson, Mississippi 39201

WATER WELL DRILLERS LOG

May 4 1970 Porter Drilling Co Wayne  
date well completed firm name county well located

LANDOWNER: Walter W. ...  
213 Humphreys Miss  
(mailing address) 033

description of formations encountered	from	to
red sand clay	0	15
white chalk	15	37
red sand chalk	37	54
chalk	54	60
sand 66-71 clean	60	71
chalk	71	74
fine sand	74	90
hard sand	90	97
stagnant white		
still in sand		

WELL LOCATION:  
sec. 9 T. 8 S. R. 7 E.  
2 miles W of Waynesboro  
(distance) (direction) (nearest town)

WELL PURPOSE: house  
(home, irrigation, municipal, industrial)

WELL COMPLETION DATA:

(1) diameter (inches) 2"

(2) total depth (feet) 97'

(3) static water level (feet) 57' below top of ground.

(4) casing steel 92'  
(material) (depth)  
2" if telescope see back.  
(size)

(5) screen 5' 92'  
(length) (depth to top)  
1 1/2" belt S.S.  
(size) (material)

(6) pump 1 10  
(HP) (yield gpm)  
elec  
(type power)

(7) electric log no  
(yes or no)

(organization running log)

(8) how well bottom plugged with sand

5' 1 1/2" belt screen

2' 1/2" log with well

pack 63' 1 1/2" log

plug


0 0

DRILLERS REMARKS:

MAY 28 1970  
MISS. BD. OF WATER COM.

If well telescopes please sketch and show depths.

GROUND LEVEL

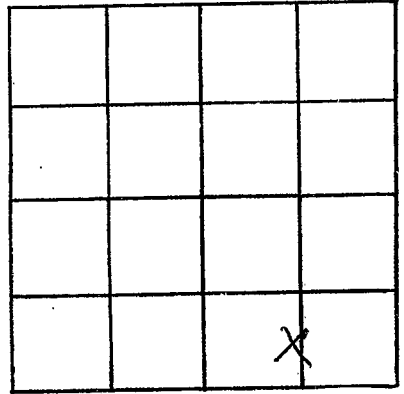

SECTION 9

Please indicate well location X.

ADDITIONAL INFORMATION

If more than one screen, show locations of each on sketch.