

Wayne  
N 110  
5-19-70

MISSISSIPPI  
BOARD OF WATER COMMISSIONERS  
416 North State Street  
Jackson, Mississippi 39201

WATER WELL DRILLERS LOG

May 19 1970 Pouder Drilling & Log Wayne  
date well completed firm name county well located

LANDOWNER: Wayne Co.  
Spring St.  
Magnuson Mine  
(mailing address) 033

WELL LOCATION:  
sec. 12 T. 30 N. R. 7 E.  
0 miles (distance) W of Waynesboro (nearest town)

WELL PURPOSE: Industrial  
(home, irrigation, municipal, industrial)

- WELL COMPLETION DATA:
- (1) diameter (inches) 4"
- (2) total depth (feet) 165'
- (3) static water level (feet) 55' below top of ground.
- (4) casing steel 135' (material) (depth)  
4" (size) If telescope see back.
- (5) screen none used (length) (depth to top)  
(size) (material)
- (6) pump 1 20 (HP) (yield gpm)  
elec. (type power)
- (7) electric log no (yes or no)  
(organization running log)
- (8) how well bottom plugged open sand


description of formations encountered	from	to
clay	0	12
sand	12	25
blue chalk	25	31
rock strata	31	38
blue chalk	38	53
rock	53	57
blue chalk	57	67
rock	67	72
gray sand	72	96
sand & chalk	96	105
blue chalk	105	135
<u>Waynesboro sandstone</u>	<u>135</u>	<u>165</u>
<u>115' 1 1/4" drop pipe</u>		

MAY 28 1970  
Miss. Bd. of  
Water Comm.

DRILLERS REMARKS:

If well telescopes please sketch and show depths.

GROUND LEVEL

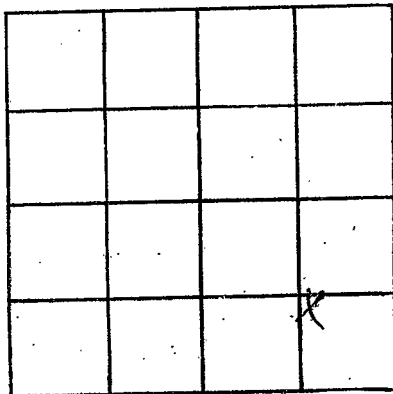

SECTION 12

Please indicate well location X.

ADDITIONAL INFORMATION

If more than one screen,  
show locations of each on sketch.