

WAYNE

N 113

9-7-70

MISSISSIPPI BOARD OF WATER COMMISSIONERS 416 North State Street Jackson, Mississippi 39201

CODED

WATER WELL DRILLERS LOG

Sept 7 1970 Boone Drilling Co Name Wayne date well completed firm name county well located

LANDOWNER: Clarence Batts Rt 3 Haysboro Miss (mailing address)

WELL LOCATION: sec 16 T 80 N S R 7 E W 3 miles West Haysboro (distance) (direction) of (nearest town)

WELL PURPOSE: Home (home, irrigation, municipal, industrial)

- WELL COMPLETION DATA: (1) diameter (inches) 2" (2) total depth (feet) 383 (3) static water level (feet) 165 below top of ground (4) casing steel 353 (material) (depth) 2" (size) if telescope see back. (5) screen none used (length) (depth to top) (6) pump 1/2 HP 3 1/2 (material) (yield gpm) elec. (type power) (7) electric log no (yes or no) (organization running log) (8) how well bottom/plugged open below casing


Table with 3 columns: description of formations encountered, from, to. Rows include: silty clay fine sand, Chalk, sand, Chalk, rock strata, Chalk, Haysboro sand, silty chalk, Fluctuating, honeycombed. Includes 'CODED' stamp and date 'OCT 5 1970'.

DRILLERS REMARKS:

Miss. Bd. of WATER COMM.

If well telescopes please sketch and show depths.

GROUND LEVEL

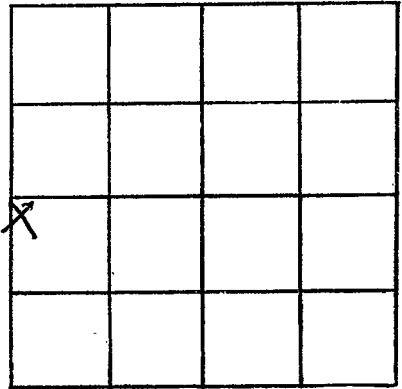

SECTION 16

Please indicate well location X.

ADDITIONAL INFORMATION

If more than one screen, show locations of each on sketch.