

WAYNE
N 114
9-29-70

MISSISSIPPI
BOARD OF WATER COMMISSIONERS
416 North State Street
Jackson, Mississippi 39201

CODED

WATER WELL DRILLERS LOG

Sept 27 1970 Porter Drilling Corp Wayne
(date well completed) (firm name) (county well located)

LANDOWNER: <u>Robert Wood</u>	description of formations encountered	from	to
<u>Plot 3 Hainesboro Miss</u> (mailing address)	<u>red clay</u>	<u>0</u>	<u>2</u>
WELL LOCATION: sec <u>3</u> T <u>90</u> N S R <u>7</u> E W <u>2</u> miles W of <u>Hainesboro</u> (distance) (direction) (nearest town)	<u>Sand</u> <u>Chalk</u> <u>lime rock coarse sand</u> <u>strat white shell in sand</u>	<u>2</u> <u>113</u> <u>77</u> <u>77</u>	<u>4.3</u> <u>77</u> <u>89</u>
WELL PURPOSE: <u>Home</u> (home, irrigation, municipal, industrial)	<u>5' 1 1/4" 8 slot S.S. well</u>		
WELL COMPLETION DATA:	<u>at 1 1/4' top hole in</u>		
(1) diameter (inches) <u>2"</u>	<u>well packer</u>		
(2) total depth (feet) <u>89</u>	<u>27 1/4" drop pipe</u>		
(3) static water level (feet) <u>78 1/2</u> (below top of ground)			
(4) casing <u>steel</u> <u>83'</u> (material) (depth)			
<u>2"</u> (size) if telescope see back.			
(5) screen <u>5'</u> <u>84'</u> (length) (depth to top)			
<u>1 1/4"</u> (size) <u>8 slot S.S.</u> (material)			
(6) pump <u>1 1/2</u> (HP) <u>12</u> (yield gpm)			
<u>elec.</u> (type power)			
(7) electric log <u>no</u> (yes or no)			
(organization running log)			
(8) how well bottom plugged <u>flush point</u>			
DRILLERS REMARKS:			


CODED

NCI 1170

MISS. BU. OF WATER CONTROL

If well telescopes please sketch and show depths.

GROUND LEVEL

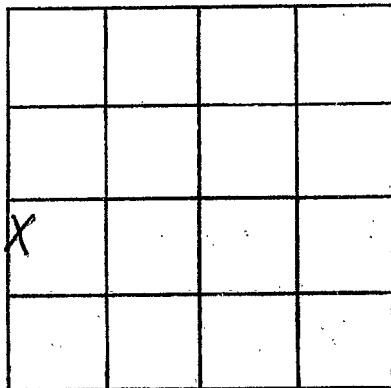

SECTION 3

Please indicate well location X.

ADDITIONAL INFORMATION

If more than one screen,
show locations of each on sketch.