

Wayne
 N 115
 5-24-70

MISSISSIPPI
 BOARD OF WATER COMMISSIONERS
 416 North State Street
 Jackson, Mississippi 39201

CODED

WATER WELL DRILLERS LOG

May 24 1970 Key West Water Wells Wayne
 date well completed firm name county well located

LANDOWNER: J. C. Johnson
 Rt 3
 Waynesboro
 (mailing address)

description of formations encountered	from	to
Sandy clay	0	16
Sand	16	57
Clay	57	80
fine sand	80	89
Blue clay	89	250
Sand	250	270

WELL LOCATION:
 sec. 4 T 8 N R 7 E
 10 miles West of Waynesboro
 (distance) (direction) (nearest town)

WELL PURPOSE: home
 (home, irrigation, municipal, industrial)

WELL COMPLETION DATA:

(1) diameter (inches) 2

(2) total depth (feet) 270

(3) static water level (feet) 128 below top of ground.

(4) casing galv. 260
 (material) (depth)
 (size) if telescope see back.

(5) screen none
 (length) (depth to top)
 (size) (material)

(6) pump 1 7
 (HP) (yield gpm)
 Rea
 (type power)

(7) electric log No
 (yes or no)
 (organization running log)

CODED

(8) how well bottom plugged wash water


III 2 1970

DRILLERS REMARKS:

MISS. BD. OF
 WATER COMM.

If well telescopes please sketch and show depths.

GROUND LEVEL

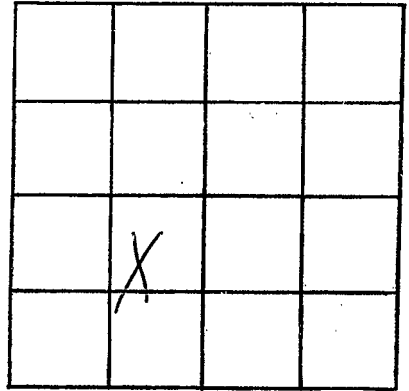

SECTION 4

Please indicate well location X.

ADDITIONAL INFORMATION

If more than one screen,
show locations of each on sketch.