

MISSISSIPPI
BOARD OF WATER COMMISSIONERS
416 North State Street
Jackson, Mississippi 39201

CODED

WATER WELL DRILLERS LOG

Wayne
N 116
6-22-70

June 22 1970 Ray W. ... water wells company
date well completed firm name county well located

LANDOWNER: <u>Selow McMichael</u>	description of formations encountered	from	to
<u>Rt 3</u>			
<u>Waynesboro</u> (mailing address)	<u>clay</u>	<u>0</u>	<u>8</u>
	<u>gravel</u>	<u>8</u>	<u>55</u>
	<u>sand</u>	<u>55</u>	<u>91</u>

WELL LOCATION:
sec. 12 T. 8 N. R. 7 E.
14 miles W of Waynesboro
(distance) (direction) (nearest town)

WELL PURPOSE: home
(home, irrigation, municipal, industrial)

CODED

- WELL COMPLETION DATA:
- (1) diameter (inches) 2
 - (2) total depth (feet) 91
 - (3) static water level (feet) 18 below above top of ground.
 - (4) casing galv 86
(material) (depth)
 - (size) if telescope see back.
 - (5) screen 5 ft 86
(length) (depth, to top)
 - 1/4 st steel
(size) (material)
 - (6) pump 1 12
(HP) (yield gpm)
 - REA
(type power)
 - (7) electric log no
(yes or no)

(organization running log)
(8) how well bottom plugged washed


111 2 1970

DRILLERS REMARKS:

MISS. BD. OF
WATER COMMISSIONERS

If well telescopes please sketch and show depths.

GROUND LEVEL

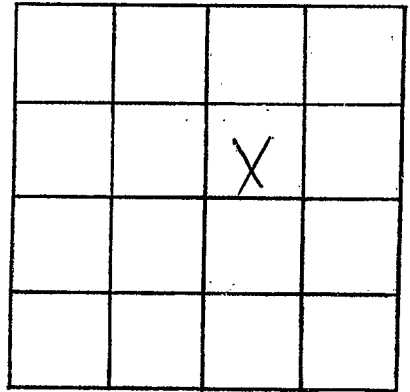

SECTION 6

Please indicate well location X.

ADDITIONAL INFORMATION

If more than one screen,
show locations of each on sketch.