

MISSISSIPPI
BOARD OF WATER COMMISSIONERS
416 North State Street
Jackson, Mississippi 39201

CODED

WATER WELL DRILLERS LOG

Wayne
N 117
7-8-70
~~JULY 8~~
JULY 8 1970

20 HOLLAND'S WELL SERVICE WAYNE
date well completed firm name county well located

LANDOWNER: M. L. MCGILL
ROUT 3
WAYNESBORO, MISS
(mailing address)

description of formations encountered	from	to
RED CLAY	0	8
" SAND	8	28
WHITE CHALK	28	33
LIGHT RED SAND	33	84
GRAY CHALK	84	90
WHITE CHALK	90	101
WHITE WATER SAND	101	107

WELL LOCATION:
sec. 9 T 8 N R 7 E
3 miles W of WAYNESBORO
(distance) (direction) (nearest town)

WELL PURPOSE: HOME
(home, irrigation, municipal, industrial)

- WELL COMPLETION DATA:
- diameter (inches) 2"
 - total depth (feet) 107
 - static water level (feet) 70 below above top of ground.
 - casing PLASTIC, 100'
(material) (depth)
2" If telescope see back.
(size)
 - screen 10' 97'
(length) (depth to top)
2" PLASTIC
(size) (material)
 - pump 1 4
(HP) (yield gpm)
ELECTRIC
(type power)
 - electric log NO
(yes or no)
- (organization running log)
- (8) how well bottom plugged BACK
WASH VALVE

CODED


JUL 24 1970

MISS. BD. OF
WATER COMMISSIONERS

DRILLERS REMARKS:

If well telescopes please sketch and show depths.

GROUND LEVEL

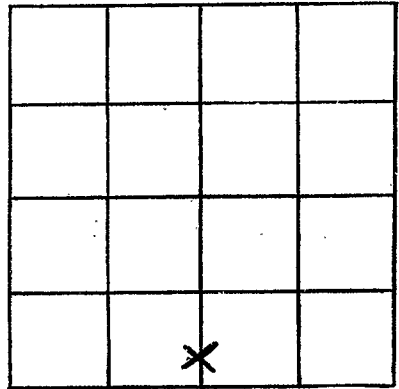

SECTION 9

Please indicate well location X.

ADDITIONAL INFORMATION

If more than one screen, show locations of each on sketch.