

WAYNE
N118
10-23-70

MISSISSIPPI
BOARD OF WATER COMMISSIONERS
416 North State Street
Jackson, Mississippi 39201

CODED

WATER WELL DRILLERS LOG

Oct 33 1970 date well completed
 20 Burt Drilling & Log firm name
 Wayne county well located

LANDOWNER: J. S. Conley
 Rt 3 Thurgood Mrs
 (mailing address)

WELL LOCATION:
 sec. 17 T. 20 N. R. 7 E. S. 1 W.
 3 1/2 miles (distance) (direction) of Thurgood (nearest town)

WELL PURPOSE: for pump
 (home, irrigation, municipal, industrial)

- WELL COMPLETION DATA:
- (1) diameter (inches) 4"
 - (2) total depth (feet) 127
 - (3) static water level (feet) 70 below top of ground
 - (4) casing steel 112' (material) (depth)
 4" (size) if telescope see back
 - (5) screen 10' 119' (length) (depth to top)
 3500 (size) (material)
 - (6) pump 12 (HP) 30 (yield gpm)
 elec (type power)
 - (7) electric log yes (yes or no)
- (organization running log)
- (8) how well bottom plugged

description of formations encountered	from	to
red clay	0	6
at all 1.	6	13
yellow sand		15
chalky mopping sand	13	100
hard, red sand	100	117
coarse clean sand	117	127
stop it while still in sand		
10' 3/200' 3' about 55'		
with 7' 2 1/2" diameter		
about on ground		
102' 1 1/4" diameter pipe		


CODED

NOV 16 1970

DRILLERS REMARKS:

If well telescopes please sketch and show depths.

GROUND LEVEL

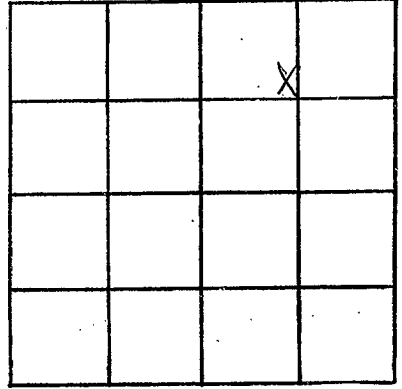

SECTION 17

Please indicate well location X.

ADDITIONAL INFORMATION

If more than one screen,
show locations of each on sketch.