

WAYNE
N 119
11-2-70

MISSISSIPPI
BOARD OF WATER COMMISSIONERS
416 North State Street
Jackson, Mississippi 39201

CODED

WATER WELL DRILLERS LOG

NOV. 2 1970 HOLLAND'S WELL SERVICE WAYNE
date well completed firm name county well located

LANDOWNER: JACK DAVIS
ROUT 1
WAYNESBORO, MISS.
(mailing address)
WELL LOCATION:
sec. 5 T 8 S R 7 E
4 miles WEST of WAYNESBORO
(distance) (direction) (nearest town)

description of formations encountered	from	to
TOP SOIL	0	2
RED CLAY	2	12
LIGHT RED SAND	12	31
WHITE CHALK	31	33
COARSE WATER SAND	33	41

WELL PURPOSE: HOME
(home, irrigation, municipal, industrial)

WELL COMPLETION DATA:
(1) diameter (inches) 2"
(2) total depth (feet) 41'
(3) static water level (feet) 27' below top of ground
(4) casing PLASTIC 36' (material) (depth)
2" if telescope see back. (size)
(5) screen 5' 36' (length) (depth to top)
2" PLASTIC (size) (material)
(6) pump 1/2 4 (HP) (yield-gpm)
ELECT (type power)
(7) electric log NO (yes or no)

CODED

(organization running log)
(8) how well bottom plugged B.W.V.


NOV 17 1970

DRILLERS REMARKS:

MISS. BD. OF
WATER COMM.

If well telescopes please sketch and show depths.

GROUND LEVEL

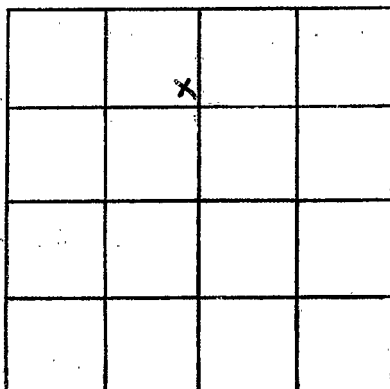

SECTION 5

Please indicate well location X.

ADDITIONAL INFORMATION

If more than one screen,
show locations of each on sketch.