

WAYNE  
N124  
4-28-71

MISSISSIPPI  
BOARD OF WATER COMMISSIONERS  
416 North State Street  
Jackson, Mississippi 39201

**CODED**

WATER WELL DRILLERS LOG

April 28 1971 Bob Drilling Co Wayne  
(date well completed) firm name county well located

LANDOWNER: John Calvin  
Tracy

description of formations encountered	from	to
red clay	0	15
sand	15	42
sand & chalk	42	53
chalk	53	84
sand with some chalk	84	95
shallow sand & gravel		
with some chalk		

At 4 Wagneshorn near W  
(mailing address)

WELL LOCATION:  
sec. 7 T. 20 N. R. 7 E. W. S.  
5 miles W of Wagneshorn  
(distance) (direction) (nearest town)

WELL PURPOSE: farm  
(home, irrigation, municipal, industrial)

WELL COMPLETION DATA:

- (1) diameter (inches) 2
- (2) total depth (feet) 95'
- (3) static water level (feet) 56 (below above top of ground)
- (4) casing steel 89 1/2'  
(material) (depth)  
2" If telescope see back.  
(size)
- (5) screen 5' 90  
(length) (depth to top)  
1 1/4" 6 slot SS.  
(size) (material)
- (6) pump 1 6  
(HP) (yield gpm)  
elec  
(type power)
- (7) electric log no  
(yes or no)
- (organization running log)
- (8) how well bottom plugged: flush gravel

5' 1 1/2' 6 slot SS.  
well 1' 1 1/4' long head  
in well packed  
63' 1 1/4" drop pipe

**CODED**


DRILLERS REMARKS:

MISSISSIPPI  
MAY 6 1971

MISS. Bd. of  
WATER COMM.

If well telescopes please sketch and show depths.

GROUND LEVEL

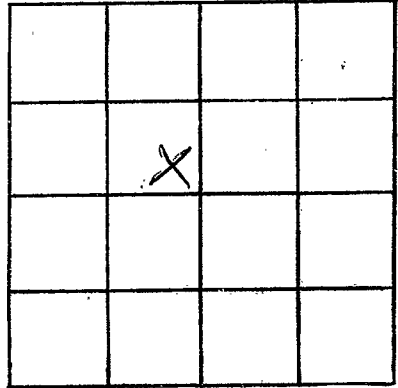

SECTION 2

Please indicate well location X.

ADDITIONAL INFORMATION

If more than one screen, show locations of each on sketch.