

WAYNE
N 125
4-28-71

MISSISSIPPI
 BOARD OF WATER COMMISSIONERS
 416 North State Street
 Jackson, Mississippi 39201

CODED

WATER WELL DRILLERS LOG

April 28 1971 Port Drilling Co Wayne
 date well completed firm name county well located

LANDOWNER: John Cotton
Trigg
At 4 Waynesboro Miss
 (mailing address)

WELL LOCATION:
 sec. 1 T. 8 N. R. 7 E.
1/2 miles N. of Waynesboro
 (distance) (direction) (nearest town)

WELL PURPOSE: Home
 (home, irrigation, municipal, industrial)

WELL COMPLETION DATA:
 (1) diameter (inches) 2"
 (2) total depth (feet) 142
 (3) static water level (feet) 76 below above top of ground.
 (4) casing steel 113
 (material) (depth)
2' if telescope see back.
 (size)
 (5) screen none used
 (length) (depth to top)
 (size) (material)
 (6) pump 1 1/2 10
 (HP) (yield gpm)
elec.
 (type power)
 (7) electric log no
 (yes or no)
 (organization running log)
 (8) how well bottom plugged open

| description of formations encountered | from | to |
|---------------------------------------|------------|------------|
| <u>sand</u> | <u>0</u> | <u>5</u> |
| <u>sand</u> | <u>5</u> | <u>18</u> |
| <u>blue Chalk</u> | <u>18</u> | <u>49</u> |
| <u>rock strata</u> | <u>49</u> | <u>70</u> |
| <u>Chalk</u> | <u>70</u> | <u>72</u> |
| <u>sand</u> | <u>72</u> | <u>110</u> |
| <u>blue Chalk</u> | <u>110</u> | <u>113</u> |
| <u>Waynesboro</u> | <u>113</u> | <u>142</u> |

84' 1 1/2" drug pipe
(11)

CODED


MAY 6 - 1971

DRILLERS REMARKS:

MISS. BD. OF
 WATER COM. L.

If well telescopes please sketch and show depths.

GROUND LEVEL

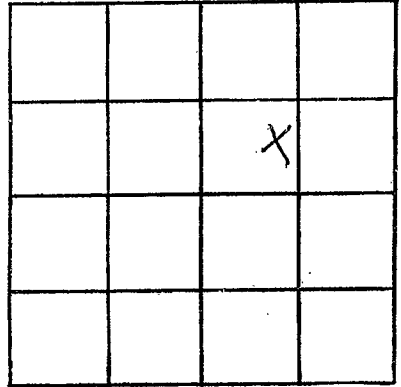

SECTION 1

Please indicate well location X.

ADDITIONAL INFORMATION

If more than one screen,
show locations of each on sketch.