

WAYNE
N 126
5-3-71

MISSISSIPPI
BOARD OF WATER COMMISSIONERS
416 North State Street
Jackson, Mississippi 39201

CODED

WATER WELL DRILLERS LOG

May 3 days well completed 19 71 HOLLAND'S WATERWELL SERV. firm name WAYNE county well located

LANDOWNER: WARD KELLY
ROUT 1

description of formations encountered	from	to
<u>TOP SOIL</u>	<u>0</u>	<u>2</u>
<u>HARD WHITE CHALK</u>	<u>2</u>	<u>27</u>
<u>MEDIUM LIGHT WATER SAND</u>	<u>27</u>	<u>39</u>

WAYNESBORD, MISS.
(mailing address)

WELL LOCATION:
sec. 17 T. 8 S. R. 7 E.
3 miles SW of WAYNESBORD
(distance) (direction) (nearest town)

WELL PURPOSE: HOME
(home, irrigation, municipal, industrial)

WELL COMPLETION DATA:

- (1) diameter (inches) 2"
- (2) total depth (feet) 39'
- (3) static water level (feet) 25' ^{below} above top of ground.
- (4) casing PLASTIC, 33'
(material) (depth).
2" if telescope see back.
(size)
- (5) screen 6', 33'
(length) (depth to top)
1 1/4" PLASTIC
(size) (material)
- (6) pump 1 4
(HP) (yield gpm)
ELECT.
(type power)
- (7) electric log NO
(yes or no)

CODED

(organization running log)

MAY 21 1971


(8) how well bottom plugged PLUG

MISS. BD. OF
WATER COMMISSIONERS

DRILLERS REMARKS:

If well telescopes please sketch and show depths.

GROUND LEVEL

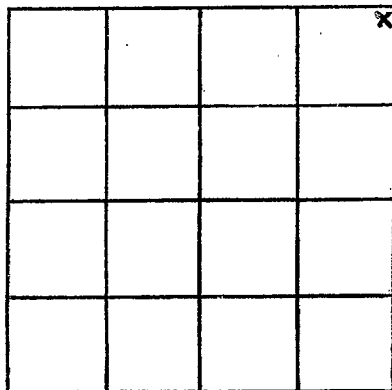

SECTION 17

Please indicate well location X.

ADDITIONAL INFORMATION

If more than one screen,
show locations of each on sketch.