

WAYNE
N127
5-62 G.P.

WATER WELL DRILLERS LOG

CODED

Date: May, 1962, Driller: Peepert Rutledge County Wayne
(Name)
365/16,28

(1) Owner of Land: Cecil Davis
(Name)

(Address)

(2) Location: 1/4, 1/4, Sec. 30 T 8 R 7,
5 miles W, of Waynesboro
(distance) (direction) (Nearest Town)

(3) Topography: Hilly
(Hilly) (Flat) (Level)

(4) Purpose of Well: Domestic
(Domestic Irrigation
Municipal, Industrial, Other)

Description & Color of Materials Sand, Clay, Red Clay, Shell, etc.	Thick- ness Feet	Depth Feet
0-80 Clay & silt	60	60
Clay - limy & red	80	140
Block of Mat	50	190
Sand	20	210

Information upon completion of well:

(1) Diameter 2" inches.

(2) Total Depth 210 feet.

(3) Water Level 90 feet below top of ground.

(4) Cased to 205, Size 2"

(5) Screen: Size 2", Length 6'


(6) Were any formations sealed against pollution?
_____ yes, no.

CODED

If YES depth of formation _____

Why _____

Drillers Remarks: _____

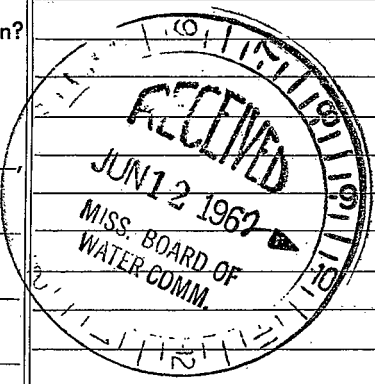

(Use Back Side)

Well No.

