

WAYNE
N 129
6-25-71

MISSISSIPPI
BOARD OF WATER COMMISSIONERS
416 North State Street
Jackson, Mississippi 39201

CODED

WATER WELL DRILLERS LOG

June 25 1971 Paul Drilling Co. Wayne
date well completed firm name county well located

LANDOWNER: Paul Russell

description of formations encountered	from	to
sand	0	17
with shales	17	55
blue chalk	55	104
shell	104	109
claystone	109	135

At 37 N. Mainboro Miss
(mailing address)

WELL LOCATION:
sec. 11 T. 80 N. R. 7 E. W. 1
(distance) miles (direction) of (nearest town)

WELL PURPOSE: Home
(home, irrigation, municipal, industrial)

WELL COMPLETION DATA:

- (1) diameter (inches) 2'
- (2) total depth (feet) 135'
- (3) static water level (feet) 21' below above top of ground.
- (4) casing steel 109'
(material) (depth)
2' if telescope see back.
(size)
- (5) screen none used
(length) (depth to top)
(size) (material)
- (6) pump 3/4 15
(HP) (yield gpm)
elec.
(type power)
- (7) electric log no
(yes or no)

CODED

(8) how well bottom plugged open


DRILLERS REMARKS:

JUL 14 1971

MISS. CO. OF
WATER COMMISSIONERS

If well telescopes please sketch and show depths.

GROUND LEVEL

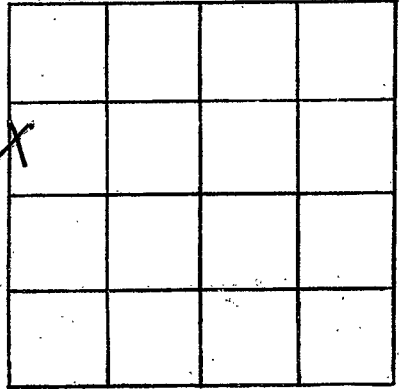

SECTION 11

Please indicate well location X.

ADDITIONAL INFORMATION

If more than one screen,
show locations of each on sketch.