

CODED

WAYNE

N-130

7-27-71

MISSISSIPPI
BOARD OF WATER COMMISSIONERS
416 North State Street
Jackson, Mississippi 39201

WATER WELL DRILLERS LOG

CODED

July 27 1971 Porter Drilling & Sup Wayne
date well completed firm name county well located

LANDOWNER: V. V. Cochran

description of formations encountered from to

At 3 Waynesboro Miss
(mailing address)

<u>Sand</u>	<u>0</u>	<u>11</u>
<u>Chalk</u>	<u>11</u>	<u>27</u>
<u>Thin rocks</u>		<u>27</u>
<u>blue chalk</u>	<u>27</u>	<u>38</u>
<u>rock strata</u>	<u>25</u>	<u>38</u>
<u>blue chalk</u>	<u>61</u>	<u>106</u>
<u>Wicksburg rock</u>	<u>20</u>	<u>106</u>
	<u>53</u>	<u>135</u>

WELL LOCATION:

sec. 10 T. 8 N. R. 7 E.
S. W. W. of Waynesboro
(distance) (direction) (nearest town)

WELL PURPOSE: Gravel Bank
(home, irrigation, municipal, industrial)

WELL COMPLETION DATA:

- (1) diameter (inches) 4"
- (2) total depth (feet) 135'
- (3) static water level (feet) 26 (below/above top of ground)
- (4) casing steel (material) 108' (depth)
- 4" (size) if telescope see back.
- (5) screen none used (length) (depth to top)
- (size) (material)
- (6) pump 1 (HP) 20 (yield gpm)
- elec. (type power)
- (7) electric log no (yes or no)
- (organization running log)

63' 1" drop pipe

CODED

(8) how well bottom plugged open


DRILLERS REMARKS:

AUG 24 1971

MISS. DEPT. OF WATER RESOURCES

If well telescopes please sketch and show depths.

GROUND LEVEL

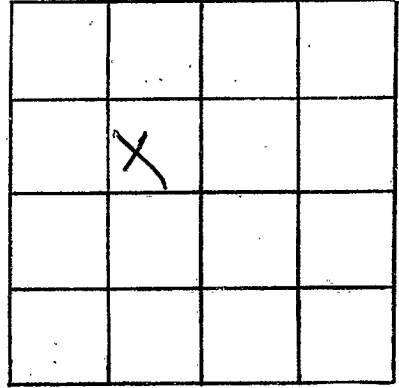

SECTION 10

Please indicate well location X.

ADDITIONAL INFORMATION

If more than one screen, show locations of each on sketch.