

WAYNE

CODED

MISSISSIPPI
BOARD OF WATER COMMISSIONERS
416 North State Street
Jackson, Mississippi 39201

CODED

WATER WELL DRILLERS LOG

N-131
8-10-71

Aug 10 1971 Port. Drilling & Pipe Wayne
date well completed firm name county well located

LANDOWNER: Southern
Pipeline Const. Co.

| description of formations encountered | from | to |
|---------------------------------------|------|-----|
| red sand & chalk | 0 | 80 |
| blue chalk & sand | 80 | 105 |
| blue chalk | 105 | 114 |
| rock strata | 114 | 144 |
| solon chalk | 144 | 193 |
| Wicksburg rock | 193 | 223 |

At 3 Wagnesham Min
(mailing address)

WELL LOCATION:
sec. 10 T 30 N R 7 E W
2 miles W Wagnesham
(distance) (direction) of (nearest town)

WELL PURPOSE: ~~residence~~
(home, irrigation, municipal, industrial)

WELL COMPLETION DATA:

(1) diameter (inches) 2"

(2) total depth (feet) 223

(3) static water level (feet) 102 (below above top of ground)

(4) casing (material) steel (depth) 193'
2" (size) if telescope see back.

(5) screen none used (length) (depth to top)
(size) (material)

(6) pump 1/2 (HP) 7 (yield gpm)
elec. (type power)

(7) electric log no (yes or no)
(organization running log)

(8) how well bottom plugged system

126' 1 1/4" deep pipe

CODED


AUG 24 1971

DRILLERS REMARKS:

MISS. Bd. of
WATER COMMISSIONERS

If well telescopes please sketch and show depths.

GROUND LEVEL

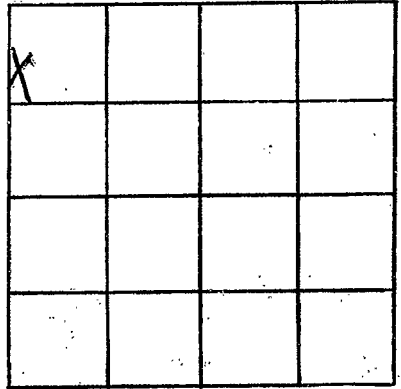

SECTION 10

Please indicate well location X.

ADDITIONAL INFORMATION

If more than one screen, show locations of each on sketch.