

CODED

Wayne
N133
2-15-72

MISSISSIPPI
BOARD OF WATER COMMISSIONERS FEB 29 1972
416 North State Street
Jackson, Mississippi 39201

MISS. BD.
WATER

WATER WELL DRILLERS LOG


Feb 15 1972 date well completed
Porter Drilling Co. firm name
Wayne county well located

LANDOWNER: <u>N.D. Cooley</u>	description of formations encountered	from	to
<u>Rt 32 Waynesboro Miss</u> (mailing address)	<u>red clay</u>	<u>0</u>	<u>15</u>
WELL LOCATION: sec. <u>8</u> T. <u>8</u> (N) R. <u>7</u> (E) <u>3</u> miles <u>west</u> of <u>Waynesboro</u> (distance) (direction) (nearest town)	<u>Chalk & sand</u>	<u>15</u>	<u>22</u>
WELL PURPOSE: <u>for water</u> (home, irrigation, municipal, industrial)	<u>blue rock</u>	<u>22</u>	<u>22</u>
WELL COMPLETION DATA:	<u>Chalk</u>	<u>22</u>	<u>88</u>
(1) diameter (inches) <u>2"</u>	<u>lost circulation</u>	<u>at 88'</u>	
(2) total depth (feet) <u>117'</u>	<u>blue chalk & sand</u>	<u>88</u>	<u>95</u>
(3) static water level (feet) <u>71'</u> (below/above top of ground)	<u>sand and</u>	<u>95</u>	<u>112</u>
(4) casing <u>steel</u> <u>112'</u> (material) (depth)	<u>Course red sand</u>	<u>112</u>	<u>117</u>
<u>2"</u> (size) if telescope see back.	<u>fine sand & chalk</u>	<u>117</u>	<u>118</u>
(5) screen <u>5'</u> <u>112'</u> (length) (depth to top)			
<u>1/4"</u> (size) <u>8 slots S.S.</u> (material)	<u>5' 1/4" 8 slot S.S. with</u>		
(6) pump <u>1 1/2</u> <u>10</u> (HP) (yield gpm)	<u>3' 1/4" large hole in with</u>		
<u>elec.</u> (type power)	<u>washer</u>		
(7) electric log <u>no</u> (yes or no)	<u>84' 1/4" drop pipe</u>		
(organization running log)			
(8) how well bottom plugged <u>flush ground</u>			
DRILLERS REMARKS:			

CODED

If well telescopes please sketch and show depths.

GROUND LEVEL

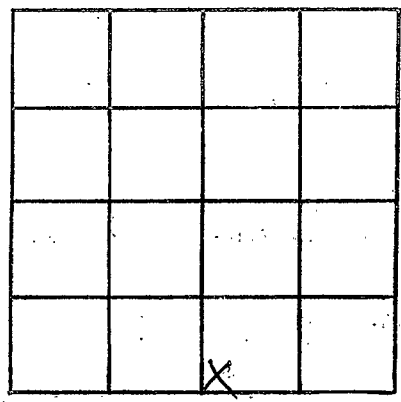

SECTION 2

Please indicate well location X.

ADDITIONAL INFORMATION

Lined area for additional information.

If more than one screen, show locations of each on sketch.