

Wayne
N142
6-23-72

C. P. CLARK
MISSISSIPPI WATER WELL DRILLING
BOARD OF WATER COMMISSIONERS
ROUTE 2
416 North State Street
Jackson, Mississippi 39201
LAUREL, MISS. 39440

WATER WELL DRILLERS LOG

CODED

6/23 1972 C.P. Clark Wayne
date well completed firm name county well located

LANDOWNER: John T. Maynes

Rt #1 Waynesboro

Miss

(mailing address)

description of formations encountered

from

to

Sandy clay
Sand
Sandy gravel

0 4
4 60
60 131

WELL LOCATION:

sec. 6 T. 5(N) R. 7 E
5 miles W of Waynesboro
(distance) (direction) (nearest town)

WELL PURPOSE: Home
(home, irrigation, municipal, industrial)

WELL COMPLETION DATA:

- (1) diameter (inches) 2
- (2) total depth (feet) 131
- (3) static water level (feet) 65 below top of ground.
- (4) casing Galv. Iron (material) 2 (depth) (size) if telescope see back.
- (5) screen 5 (length) 126 (depth to top) 1 1/4 (size) Solid SS. 010 (material)
- (6) pump 1 (HP) 1 1/2 (yield gpm) 220V S.P. (type power)
- (7) electric log no (yes or no)
- (organization running log)
- (8) how well bottom plugged Bwv

C. P. CLARK
WATER WELL DRILLING
ROUTE 2
LAUREL, MISS. 39440

CODED


JUN 23 1972

MISS. PD. OF
WATER CONTROL

DRILLERS REMARKS: Set 12A
Get @ 105 ft used
Chlorine F & W pump

If well telescopes please sketch and show depths.

GROUND LEVEL

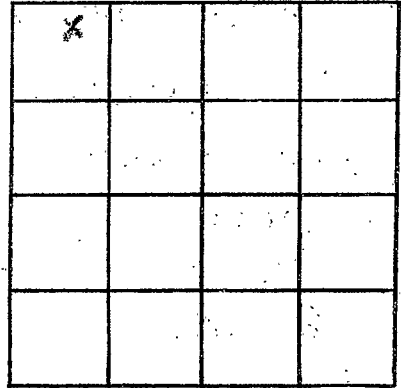

SECTION 6

Please indicate well location X.

ADDITIONAL INFORMATION

If more than one screen, show locations of each on sketch.