

WAYNE

N147

10-16-72

MISSISSIPPI

BOARD OF WATER COMMISSIONERS

416 North State Street

Jackson, Mississippi 39201

WATER WELL DRILLERS LOG

Sept 16 1972 date well completed

Route 5000 firm name

Wayne county well located

LANDOWNER: Aden Barnett

description of formations encountered

from

to

Rt 3 Waynesboro Miss (mailing address)

WELL LOCATION:

sec. 17 T 8 S R 7 E 3 miles west of Waynesboro (distance) (direction) (nearest town)

WELL PURPOSE: home (home, irrigation, municipal, industrial)

WELL COMPLETION DATA:

- (1) diameter (inches) 2'
(2) total depth (feet) 330'
(3) static water level (feet) 120' below top of ground.
(4) casing steel 298 (material) (depth) 2" (size) If telescope see back.
(5) screen none (length) (depth to top)
(6) pump 2 (HP) 6 (yield gpm) elec (type power)
(7) electric log no (yes or no)
(organization running log)
(8) how well bottom plugged open

Table with 3 columns: description of formations encountered, from, to. Rows include: red clay (0-15), sand (15-30), mottled chalk (30-75), sand (75-130), blue chalk (130-175), rock strata (175-202), blue chalk (202-206), sand & chalk (206-211), rock strata (211-217), blue chalk (217-219), sand some chalk (219-230), clean sand (230-249), blue chalk (249-297), thickening rock (297-330)

147' 1 1/2" drage pipe


WAYNE

OCT 19 1972

DRILLERS REMARKS:

If well telescopes please sketch and show depths.

GROUND LEVEL

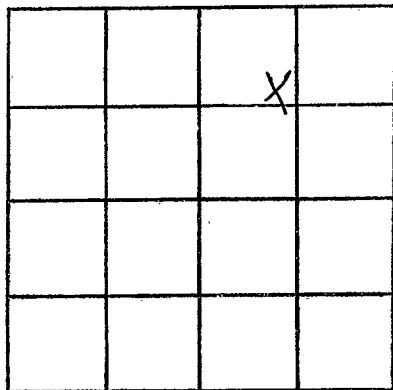

SECTION 17

Please indicate well location X.

ADDITIONAL INFORMATION

If more than one screen,
show locations of each on sketch.