

**MISSISSIPPI
BOARD OF WATER COMMISSIONERS**

416 North State Street
Jackson, Mississippi 39201

WATER WELL DRILLERS LOG

Wayne
N 148
11-2-72
Nov 2 1972

R. R. Roubin Drilling firm name Wayne county well located

LANDOWNER: Gene Cochran

description of formations encountered	from	to
	clean sand	0
chalk	12	21
rock strata	21	24
sand	24	37
chalk	37	76
rock strata	76	82
white chalk	82	110
some rock	110	135
sand	135	142
rock	142	143
blue chalk	143	150
sand	150	160
blue chalk	160	287
rock strata	287	292
blue chalk	292	356
rock strata	356	379
Coconut sand	379	390
rock strata	390	401
blue chalk	401	456
thin rock		456
thin rock		461
thin rock		510
rock	510	520
thin rock		535
thin rock hard		537 1/2
chalk	401	544
some sand	544	557
crinfield		
stiff chalk	557	570

Waynesboro, Miss
(mailing address)

WELL LOCATION:
sec. 8 T. 80 N. R. 7 E. W
inside Waynesboro
(distance) miles (direction) of (nearest town)

WELL PURPOSE: pond strata
(home, irrigation, municipal, industrial)

WELL COMPLETION DATA:

- (1) diameter (inches) 2 1/2
- (2) total depth (feet) 570'
- (3) static water level (feet) 4 below top of ground. (above)
- (4) casing steel 456
(material) (depth)
2' if telescope see back. (size)
- (5) screen none used
(length) (depth to top)
(size) (material)
- (6) pump none 4
(HP) (yield gpm)
(type power)
- (7) electric log no
(yes or no)
(organization running log)
- (8) how well bottom plugged open


NOV 20 1972

DRILLERS REMARKS:

WELL NO. 112
DATE 11/20/72

If well telescopes please sketch and show depths.

GROUND LEVEL

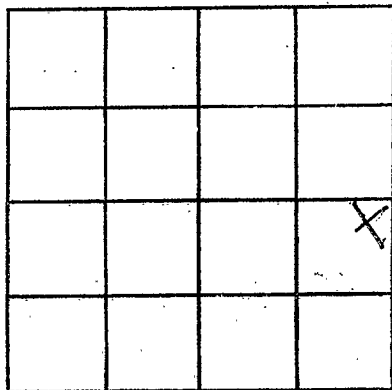

SECTION 2

Please indicate well location X.

ADDITIONAL INFORMATION

If more than one screen,
show locations of each on sketch.