

MISSISSIPPI
BOARD OF WATER COMMISSIONERS
416 North State Street
Jackson, Mississippi 39201

CODED

WATER WELL DRILLERS LOG

WAYNE
N 149
1-1-73
Jan 1 1973
date well completed

Robt. Drilling Co.
firm name
Wayne
county well located

LANDOWNER: *Richard Clark*
Johnson Farm
Agaleen Dr. Hayseshor
(mailing address)

WELL LOCATION:
sec. 6 T. 8 S. R. 7 E. W.
4 miles *west* of *Hayseshor*
(distance) (direction) (nearest town)

WELL PURPOSE: *water*
(home, irrigation, municipal, industrial)

WELL COMPLETION DATA:
(1) diameter (inches) 2"
(2) total depth (feet) 76'
(3) static water level (feet) 63' below top of ground.
(4) casing steel 70' (material) (depth)
2" (size) if telescope see back.
(5) screen 5' 70' (length) (depth to top)
1 1/4" (size) SS (material)
(6) pump 1 10 (HP) (yield gpm)
elec. (type power)
(7) electric log no (yes or no)
(organization running log)
(8) how well bottom plugged
wash out valve


description of formations encountered	from	to
<i>red clay</i>	<i>0</i>	<i>15</i>
<i>concrete pipe</i>	<i>15</i>	<i>76</i>
<i>shale</i>		
<i>silty sand</i>		
<i>5' 1 1/4" hole SS</i>		
<i>screen on case</i>		
<i>with wash out valve</i>		
<i>on end of screen</i>		
<i>67' 1/4" drop pipe</i>		

JAN 10 1973

DRILLERS REMARKS:

If well telescopes please sketch and show depths.

GROUND LEVEL

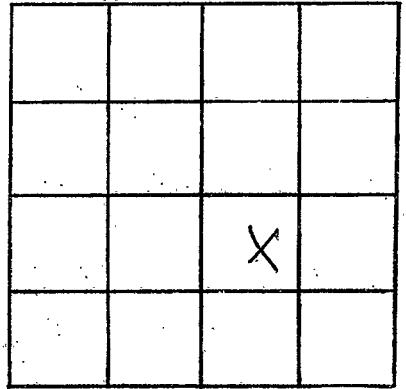

SECTION 6

Please indicate well location X.

ADDITIONAL INFORMATION

If more than one screen, show locations of each on sketch.