

**MISSISSIPPI  
BOARD OF WATER COMMISSIONERS**

416 North State Street  
Jackson, Mississippi 39201

**CODED**

**WAYNE**

**N 156**

**5-3-73**

**WATER WELL DRILLERS LOG**

date well completed May 3 1973 firm name Robert D. Dillingham county well located Wayne

LANDOWNER: J. L. Jones

description of formations encountered

from to

ad 311 Manassas Rock  
(mailing address)

sand & silt 0 6

clay 6 10

shale 10 16

blue chalk 16 22

red chert 22 42

blue chalk 42 95

blue limestone 95 106

**WELL LOCATION:**

sec. 2 T. 80 N. R. 7 E. S. W  
4 miles NW of Waynesboro  
(distance) (direction) (nearest town)

WELL PURPOSE: Home  
(home, irrigation, municipal, industrial)

**WELL COMPLETION DATA:**

(1) diameter (inches) 2"

(2) total depth (feet) 106

(3) static water level (feet) 22 below top of ground.

(4) casing steel 95'  
(material) (depth)

2" x 2" if telescope see back.  
(size)

(5) screen wire mesh  
(length) (depth to top)

(size) (material)

(6) pump 30 12  
(HP) (yield gpm)

(type power)

(7) electric log no  
(yes or no)

(organization running log)

(8) how well bottom plugged

**DRILLERS REMARKS:**


42' 20" case on bottom  
43' 2" case on top

**CODED**

**JUN 5 1973**

If well telescopes please  
sketch and show depths.

GROUND LEVEL

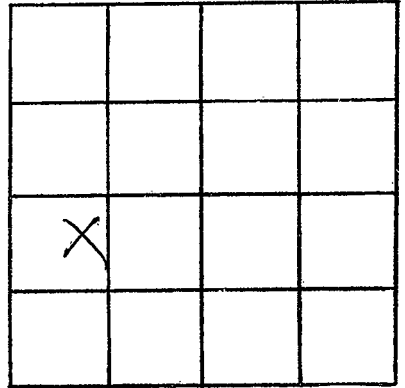

SECTION 2

Please indicate well location X.

ADDITIONAL INFORMATION

If more than one screen,  
show locations of each on sketch.