

WAYNE
N 160
6-4-73

MISSISSIPPI
BOARD OF WATER COMMISSIONERS
416 North State Street
Jackson, Mississippi 39201

CODED

WATER WELL DRILLERS LOG

June 4 1973 Porter Drilling & Log Wayne
date well completed firm name county well located

LANDOWNER Sam Smith

description of formations encountered	from	to
sand	0	15
blue chalk	15	23
rock shales	23	55
blue chalk	55	105
Vicksburg rock	105	136

At 3 Waynesboro Miss
(mailing address)

WELL LOCATION:
sec. ~~8~~ T-8 (N) R-7 E (W)
1/2 miles W of Waynesboro
(distance) (direction) (nearest town)

WELL PURPOSE: home
(home, irrigation, municipal, industrial)

WELL COMPLETION DATA:

- (1) diameter (inches) 2"
- (2) total depth (feet) 136'
- (3) static water level (feet) 22' ^{below} _{above} top of ground.
- (4) casing steel 105'
(material) (depth)
2" if telescope see back.
(size)
- (5) screen none used
(length) (depth to top)
(size) (material)
- (6) pump Custom built set own pump
(HP) (yield gpm)
(type power)
- (7) electric log no
(yes or no)
(organization running log)
- (8) how well bottom plugged open


CODED

DRILLERS REMARKS:

JUL 31 1973

If well telescopes please
sketch and show depths.

GROUND LEVEL

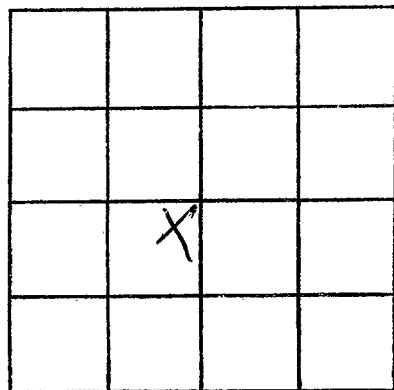

SECTION 2

Please indicate well location X.

ADDITIONAL INFORMATION

If more than one screen,
show locations of each on sketch.