

**MISSISSIPPI
BOARD OF WATER COMMISSIONERS**
416 North State Street
Jackson, Mississippi 39201

SEP 12 1973

WAYNE
N 161
7-25-73

WATER WELL DRILLERS LOG


MISS. BD. OF
WATER COMMISSIONERS

July 25 1973 Porter Drilling Log Wayne
date well completed firm name county well located

LANDOWNER: <u>John Mc Muckel Dr.</u>	description of formations encountered	from	to
<u>213 Waynesboro</u> (mailing address)			
WELL LOCATION: sec. <u>6</u> T <u>8</u> N <u>7</u> R <u>7</u> E (distance) (direction) (nearest town)	<u>red sand</u>	<u>0</u>	<u>15</u>
WELL PURPOSE: <u>home</u> (home, irrigation, municipal, industrial)	<u>red clay sand</u>	<u>15</u>	<u>40</u>
WELL COMPLETION DATA:	<u>fine sand</u>	<u>40</u>	<u>65</u>
(1) diameter (inches) <u>2"</u>	<u>hard sand</u>	<u>65</u>	<u>75</u>
(2) total depth (feet) <u>90'</u>	<u>course sand pea gravel</u>	<u>75</u>	<u>90</u>
(3) static water level (feet) <u>60</u> (below/above top of ground)	<u>stagnant shale</u>		
(4) casing <u>steel</u> <u>84'</u> (material) (depth)	<u>well in pea gravel</u>		
<u>2"</u> (size) if telescope see back,	<u>1 course sand</u>		
(5) screen <u>5'</u> <u>84'</u> (length) (depth to top)			
<u>1 1/4"</u> (size) <u>6 shot SS.</u> (material)	<u>5' 1/4' 6 shot SS</u>		
(6) pump <u>1</u> <u>10</u> (HP) (yield gpm)	<u>screen well back with valve secured on end of cas.</u>		
<u>elec.</u> (type power)	<u>21' 1/4' dry pipe</u>		
(7) electric log <u>no</u> (yes or no)	CODED		
(organization running log)			
(8) how well bottom plugged <u>bank with shale</u>			
DRILLERS REMARKS:			

If well telescopes please sketch and show depths.

GROUND LEVEL

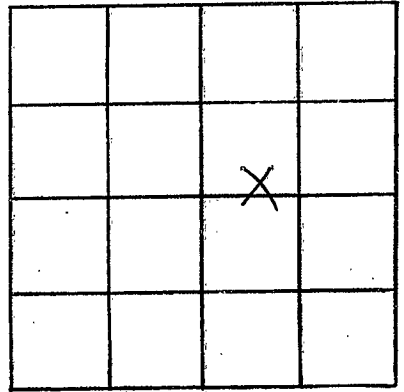

SECTION 6

Please indicate well location X.

ADDITIONAL INFORMATION

If more than one screen, show locations of each on sketch.