

**MISSISSIPPI  
BOARD OF WATER COMMISSIONERS**  
416 North State Street  
Jackson, Mississippi 39201

**CODED**

**WAYNE**

**9-N162  
9-19-13**

**WATER WELL DRILLERS LOG**

Sept 19 19 23 Porter Drilling Co Wayne  
date well completed firm name county well located

**LANDOWNER:** Maple Williams

description of formations encountered	from	to

Rt 3 Waynesboro Miss (mailing address)

red clay	0	11
conglomerate of shells	4	40
blue chalk	40	90
red	90	90 1/2
red	90 1/2	92
red chalk	92	97
red to chalk	97	103
chalk	103	136
sand	136	170
retained white shell in sand		

**WELL LOCATION:**  
sec. 35 T 8 N R 7 E  
4 miles S of Waynesboro (nearest town)

**WELL PURPOSE:** none (home, irrigation, municipal, industrial)

**WELL COMPLETION DATA:**

- (1) diameter (inches) 2'
- (2) total depth (feet) 170'
- (3) static water level (feet) 85' (below top of ground)
- (4) casing steel 162' (material) (depth) 2' (size) if telescope see back.
- (5) screen 5' 165' (length) (depth to top) 1 1/2' 6 shot S.S. (size) (material)
- (6) pump 1/2 HP 7 1/2 (HP) (yield gpm) elec (type power)
- (7) electric log no (yes or no)

5' 1/4" bag pipe in top of screen hole in with packer  
10.5' 1 1/4" drop pipe


(8) how well bottom plugged plug point

**DRILLERS REMARKS:**

OCT 9 1913

If well telescopes please  
sketch and show depths.

GROUND LEVEL

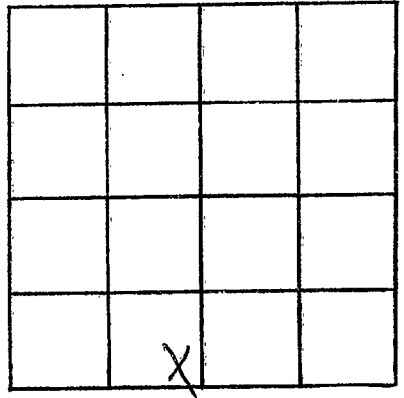

SECTION 35

Please indicate well location X.

ADDITIONAL INFORMATION

If more than one screen,  
show locations of each on sketch.