

WAYNE
N 163
11-21-73

MISSISSIPPI
 BOARD OF WATER COMMISSIONERS
 416 North State Street
 Jackson, Mississippi 39201

WATER WELL DRILLERS LOG

CODER

Nov 21, 1973
 date well completed

McILWAIN WATER WELL SERVICE

WAYNE

RT. 2, BOX 37

county well located

WAYNESBORO, MISS. 39367

LANDOWNER:

Julian Holston

description of formations encountered

from

to

RT 3 WAYNESBORO
 (mailing address)

RED CLAY + SAND
 ROCKS

0

5

WELL LOCATION:

sec. 17 T. 8 N R. 7 W
5 miles W of W'BORO
 (distance) (direction) (nearest town)

HARD CLAY

5

12

WELL PURPOSE: HOME
 (home, irrigation, municipal, industrial)

FINE SAND

12

15

WELL COMPLETION DATA:

(1) diameter (inches) 2"
 (2) total depth (feet) 105
 (3) static water level (feet) 71' below top of ground.

CLAY

15

16

(4) casing PVC 95'
 (material) (depth)
2"
 (size) If telescope see back.

FINE SAND

16

18

(5) screen 10' 95'
 (length) (depth to top)
2" PVC .008
 (size) (material)

CLAY

18

26

(6) pump 1 8
 (HP) (yield gpm)
110 AC
 (type power)

MED SAND WITH
 STREAKS OF CLAY

26

40

(7) electric log NO
 (yes or no)

MED COARSE SAND

40

50

(organization running log)

(8) how well bottom plugged

CLAY

50

61

FINE SAND

61

65

SAND + CLAY STREAKS

65

90

MED SAND

90

105

DRILLERS REMARKS:


NO - 7 1973

MR.

WAL

If well telescopes please sketch and show depths.

GROUND LEVEL

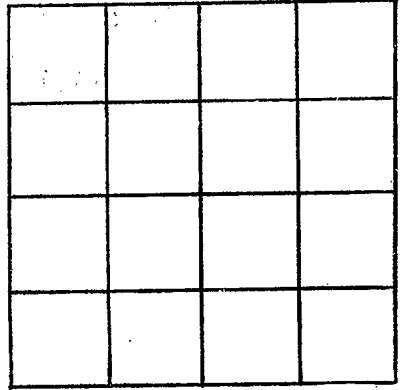

SECTION _____

Please indicate well location X.

ADDITIONAL INFORMATION

If more than one screen, show locations of each on sketch.