

WAYNE
N 164
11-28-73

MISSISSIPPI
BOARD OF WATER COMMISSIONERS
416 North State Street
Jackson, Mississippi 39201

CODED

WATER WELL DRILLERS LOG

Nov. 28, 1973
date well completed

McILWAIN WATER WELL SERVICE

WAYNE

Rt. 4 Box 37

county well located

WAYNESBORO, MISS. 39367

LANDOWNER:

description of formations encountered

from

to

Alvin Troy SANDERSON

RED CLAY

0

12

Rt 3 Box 145 W'boro
(mailing address)

RED SAND

12

35

WELL LOCATION:

sec. 7 T 8 N R 7 W
6 miles W of W'boro
(distance) (direction) (nearest town)

WHITE SAND AND
CLAY STREAKS

35

60

HARD WHITE CHALK

60

73

WELL PURPOSE: HOME
(home, irrigation, municipal, industrial)

SAND AND SOME
CLAY

73

76

WELL COMPLETION DATA:

- (1) diameter (inches) 2"
- (2) total depth (feet) 88
- (3) static water level (feet) 45' below top of ground.
- (4) casing PVC 78' (material) (depth)
2" (size) if telescope see back.
- (5) screen 10' 78' (length) (depth to top)
2" PVC .008 (size) (material)
- (6) pump 1 (HP) 11 (yield gpm)
220 AC (type power)
- (7) electric log No (yes or no)

MED SAND

76

88

(organization running log)


(8) how well bottom plugged

DRILLERS REMARKS:

DEC 7 1973

If well telescopes please sketch and show depths.

GROUND LEVEL

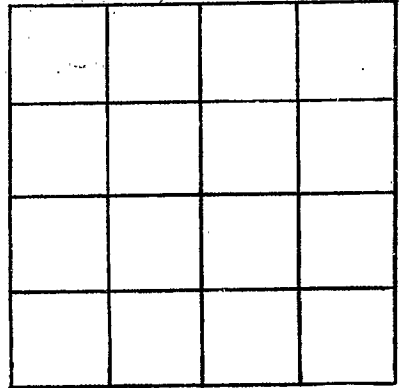

SECTION _____

Please indicate well location X.

ADDITIONAL INFORMATION

If more than one screen, show locations of each on sketch.