

**WAYNE**  
**N 166**  
**1-29-74**

MISSISSIPPI  
 BOARD OF WATER COMMISSIONERS  
 416 North State Street  
 Jackson, Mississippi 39201

CODED

WATER WELL DRILLERS LOG

Jan 29, 1974  
 date well completed

McILWAIN WATER WELL SERVICE WAYNE

RI. # BOX 37

county well located


WAYNESBORO, MISS. 39367

LANDOWNER:	description of formations encountered	from	to
Mack Barnett	Red Clay	0	8
RT 3 WAYNESBORO, Miss. (mailing address)	Sand Rock	8	9
WELL LOCATION:	White Chalk	9	20
sec. 17 T 8 N R 7 E 6 miles W of W BORO (distance) (direction) (nearest town)	Brown chalk	20	32
WELL PURPOSE: HOME (home, irrigation, municipal, industrial)	Fine sand and clay	32	35
WELL COMPLETION DATA:	grey chalk	35	45
(1) diameter (inches) 2"	Sand	45	50
(2) total depth (feet) 100'	Clay + Dome Sand	50	78
(3) static water level (feet) 65' below top of ground.	Sand	78	80
(4) casing PVC 94' (material) (depth)	Clay	80	82
2" if telescope see back. (size)	sanded	82	100
(5) screen 6' 94' (length) (depth to top)			
2" PVC .008 (size) (material)			
(6) pump 3/4 7 (HP) (yield gpm)			
110 AC (type power)			
(7) electric log NO (yes or no)			
(organization running log)			
(8) how well bottom plugged			
DRILLERS REMARKS:			

WAYNESBORO MISSISSIPPI  
 FEB 10 1974  
 WATER CO

If well telescopes please sketch and show depths.

GROUND LEVEL

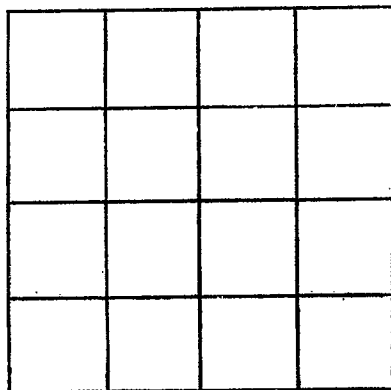

SECTION \_\_\_\_\_

Please indicate well location X.

ADDITIONAL INFORMATION

If more than one screen, show locations of each on sketch.