


WAYNE
N 167
3-28-74

MISSISSIPPI
BOARD OF WATER COMMISSIONERS CODED
416 North State Street
Jackson, Mississippi 39201

WATER WELL DRILLERS LOG

MARCH 28, 1974 date well completed
McILWAIN WATER WELL SERVICE Wayne
RT. 2 BOX 37 from nearest county well located


LANDOWNER:	description of formations encountered	from	to
J. V. COOKSEY	CLAY	0	10
WAYNESBORO, MISS (mailing address)	SAND	10	15
WELL LOCATION:	CLAY	15	17
sec. 1 T 8 N R 7 E INSIDE WAYNESBORO City Limits (distance) miles (direction) of (nearest town)	Rock & Limey Breaks	17	28
WELL PURPOSE: BAIT SHOP (home, irrigation, municipal, industrial)	CLAY	28	35
WELL COMPLETION DATA:	ROCK CODED	35	36
(1) diameter (inches) 2"	Clay + Rock	36	40
(2) total depth (feet) 70'	MED SAND	40	70
(3) static water level (feet) 40' below top of ground.			
(4) casing PVC 60' (material) (depth) 2" (size) if telescope see back.			
(5) screen 10' 60' (length) (depth to top) 2" PVC 008 (size) (material)			
(6) pump 1/2 8 (HP) (yield gpm) 220 AC (type power)			
(7) electric log no (yes or no)			
(organization running log)			
(8) how well bottom plugged			
DRILLERS REMARKS:			

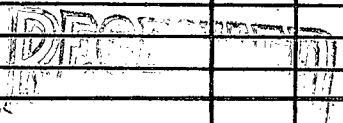

APR - 4 1974

If well telescopes please sketch and show depths.

GROUND LEVEL

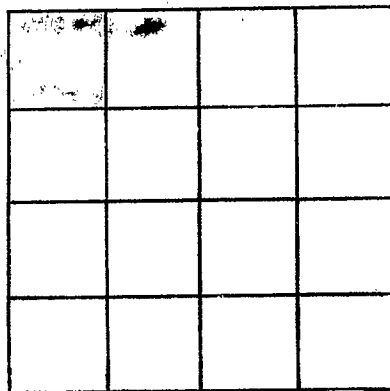

SECTION _____

Please indicate well location X.

ADDITIONAL INFORMATION

If more than one screen, show locations of each on sketch.